


WELL PLUGGING RECORD

Give All Information Completely
Make Required Affidavit
Mail or Deliver Report to:
Conservation Division
State Corporation Commission
211 No. Br. Hwy
Wichita, Kansas

Barton County. Sec. 29 Twp. 20S Rge. 13W (E) (W)

Location as "NE/CNW%SW%" or footage from lines. NW NW SW
Lease Owner Alden E. Branine
Lease Name McGreevy Well No. 1
Office Address 1609 Hillcrest - Newton, Kansas
Character of Well (completed as Oil, Gas or Dry Hole) Oil Well
Date well completed Sept. 15, 1955 19
Application for plugging filed Jan. 2, 1957 19
Application for plugging approved Dec. 20, 1956 19
Plugging commenced December 21, 1956
Plugging completed December 27, 1956
Reason for abandonment of well or producing formation Non-commercial

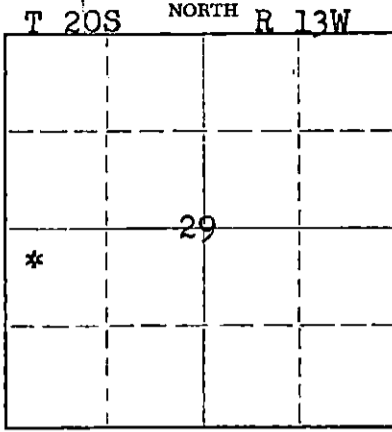

Locate well correctly on above Section Plat

If a producing well is abandoned, date of last production Nov. 1956 19
Was permission obtained from the Conservation Division or its agents before plugging was commenced? Yes

Name of Conservation Agent who supervised plugging of this well Brundege
Producing formation Iansing Depth to top 3206 Bottom 3408 Total Depth of Well 3408 Feet
Show depth and thickness of all water, oil and gas formations.

OIL, GAS OR WATER RECORDS

CASING RECORD

FORMATION	CONTENT	FROM	TO	SIZE	PUT IN	PULLED OUT
				8-5/8"	127'	None
				5-1/2"	3400'	2896'
				Pipe perforated at 3346'.		

Describe in detail the manner in which the well was plugged, indicating where the mud fluid was placed and the method or methods used in introducing it into the hole. If cement or other plugs were used, state the character of same and depth placed, from _____ feet to _____ feet for each plug set.

Filled the hole with sand from 3400' to 3330' and ran 5 sacks of cement which filled to 3295'. Pumped 20 sacks of jell mud and 80 sacks of cement into the surface pipe. Checked top of cement plug at 30', mudded the hole to 15' and ran 5 sacks of cement to base of cellar. Plugging completed.

(If additional description is necessary, use BACK of this sheet)
Name of Plugging Contractor West Supply Co., Inc.
Address Chase, Kansas

STATE OF Kansas, COUNTY OF Rice, ss.
Noel J. Knight (employee of owner) or (owner) of the above-described well, being first duly sworn on oath, says: That I have knowledge of the facts, statements, and matters herein contained and the log of the above-described well as filed and that the same are true and correct. So help me God.
(Signature) Noel J. Knight
Chase, Kansas (Address)

SUBSCRIBED AND SWORN TO before me this 28th. day of December 1956
Edward E. O'Brien
Edward E. O'Brien Notary Public.

My commission expires May 20, 1957

PLUGGING
FILE SEC. 29 T. 20 R. 13W
BOOK PAGE 129 LINE 30

CONTRACTOR'S WELL LOG

COMPANY: Branine Oil Company
 CONTRACTOR: Leben Drilling Company
 FARM: McGreevey #1
 LOCATION: NW NW SW Sec. 29-20-13
 Barton County, Kansas
 COMMENCED: September 2, 1955
 COMPLETED: September 12, 1955
 PRODUCTION: Oil

0	41	Surface Sand
41	127	Surface Sand
127	152	Iron
152	162	Sand
162	758	Shale, Redbed
758	770	Anhydrite
770	1732	Shale, lime
1732	1882	Lime
1882	3195	Lime, shale
3195	3206	Lantz
3206	3358	Lime
3358	3380	Lime, shale
3380	3408	Lime
	3408	<u>Rotary Total Depth - PRODUCTION</u>

Set 8 5/8" Surface Casing at 138 feet.

Set 5 1/2" pipe at 3406 feet.

I, Norma D. Sisson, do hereby certify that the above and foregoing is a true and correct copy of the log of the McGreevey #1, NW NW SW Sec. 29-20-13, Barton County, Kansas, as reflected by the files of the Leben Drilling Company.

LEBEN DRILLING COMPANY

BY: Norma D. Sisson

STATE OF KANSAS)
 COUNTY OF SEDGWICK) ss

Subscribed and sworn to before me, a Notary Public, in and for Sedgwick County, Kansas, this 16th day of September, 1955

Norma D. Sisson
 Notary Public

My commission expires April 20, 1959

PLUGGING

FILE SEC. 29 T. 20 R. 13W

BOOK PAGE 129 LINE 30