

STATE OF KANSAS
STATE CORPORATION COMMISSION

WELL PLUGGING RECORD


OR

FORMATION PLUGGING RECORD

Strike out upper line
when reporting plug-
ging off formations.

Give All Information Completely
Make Required Affidavit
Mail or Deliver Report to:
Conservation Division
State Corporation Commission
800 Bittling Building
Wichita, Kansas

NORTH

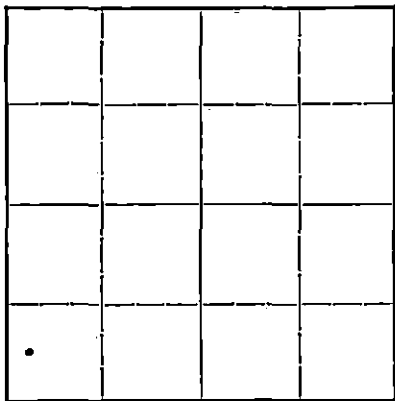

Locate well correctly on above
Section Flat

Barton County. Sec. 29 Twp 20 Rge 13 (E) W (W)
Location as "NE $\frac{1}{4}$ NW $\frac{1}{4}$ SW $\frac{1}{4}$ " or footage from lines 660 ft from South line &
330 ft from West line.
Lease Owner Atlantic Refining Co.
Lease Name McGreevy- Kuhn Well No. 1
Office Address 403 Union Natl Bank Bldg.
Character of Well (completed as Oil, Gas or Dry Hole) Org
Date, well completed June 14 19 41
Application for plugging filed June 16 19 41
Application for plugging approved June 18 19 41
Plugging Commenced June 17 19 41
Plugging Completed June 18 19 41
Reason for abandonment of well or producing formation.....

If a producing well is abandoned, date of last production..... 19.....
Was permission obtained from the Conservation Division or its agents before plugging was com-
menced?..... yes

Name of Conservation Agent who supervised plugging of this well C. T. Alexander
Producing formation K C Lime Depth to top 3243 Bottom 3487 Total Depth of Well 3528 Feet
Show depth and thickness of all water, oil and gas formations.

OIL, GAS OR WATER RECORDS

CASING RECORD


Formation	Content	From	To	Size	Put In	Pulled Out
<u>carried no show of oil</u>		<u>0</u>	<u>124</u>	<u>10" casing</u>		<u>none</u>
		<u>0</u>	<u>3333</u>	<u>7" "</u>		<u>1440 ft</u>

Describe in detail the manner in which the well was plugged, indicating where the mud fluid was placed and the method or methods used in introducing it into the hole. If cement or other plugs were used, state the character of same and depth placed, from..... feet to..... feet for each plug set.

The hole was filled with mud, cement plug was placed in the 7" casing from 3300 to 3480 feet, same being pumped through the 3" drill pipe by Williams Brothers Cementing Company. Another plug was placed at 800 feet to 780 feet in the same manner after the 7" pipe was pulled. The mud was made as heavy as the mud pump would handle it and the artesian section at 330 ft to 340 ft this mud being circulated until no trace of artesian water could be found. A bridge was made at 124 ft and 10 sacks of cement was run in the manner described above. Again mud was pumped in the hole filling to the top of it which had to bale out 18 feet and another bridge was placed at 18 feet and six sacks of cement was placed until the cement was within 6 feet of the surface and filled up 12 feet. Mr. Alexander inspected the job the day after completion of the plugging and met with his approval.

*pd
6/16/41
H.A.*

PLUGGING
FILE 29 20R/3W
BOOK GE 14 LINE 33

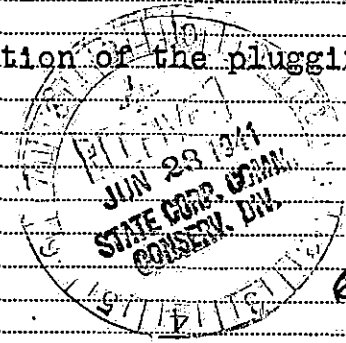

6-23-41

(If additional description is necessary, use BACK of this sheet)

Correspondence regarding this well should be addressed to Howard Kuhn- 403 Union Natl. Bank Bldg
Address Wichita, Kansas.

STATE OF Kansas, COUNTY OF Sedgwick, ss.

..... (employee of owner) or (owner or operator) of the above-described well,
being first duly sworn on oath, says: That I have knowledge of the facts, statements, and matters herein contained and the log of the above-described well as filed and that the same are true and correct. So help me God.

(Signature) Howard Kuhn

403 Union Natl. Bank Bldg.
(Address)

SUBSCRIBED AND SWORN to before me this 21st day of June, 19 41

My commission expires April 14-1945

Jennie Guillen
Notary Public.

WELL LOG BUREAU - KANSAS GEOLOGICAL SOCIETY
412 Union National Bk Bldg., Wichita, Kansas


15.009.05664.0000

HOWARD KUHN
McGreevy No. 1.

SEC.29 T.20 R.13W
CWL SW SW

Total Depth. 3528'
Comm. 4-24-41 Comp. 6-15-41
Shot or Treated.
Contractor. Clay Bros.Drlg.Co., Inc.
Issued. 7-12-41

County. Barton

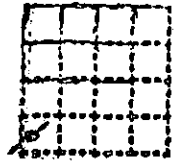

CASING:
10 3/4" 124'11" Cem.
7" 3333' Cem.

Elevation.

Production. Dry

Figures Indicate Bottom of Formations.

caliche sand shell	125	Pay 3370 also 3410
shell hrd	131	Hole filled up 250'
sand rock hrd	149	w/wtr. in hour and half
shale blue	171	3342-3347
shale & shell	332	
sand & shells	348	
sand red bed	666	
sand strks of shale & gyp	845	
red bed & shale	1040	
shale, shells, sand	1235	
shale blue, strks gyp, anhydrite & shells	1423	
shale, shells, strk salt	1575	
sdv lime, anhydrite, & strks shale	1640	
anhydrite & gyp	1665	
anhydrite w/strks lime, shale & gyp	1707	
shale strks anhydrite	1805	
shale & shells	1902	
lime & shale	1921	
shale, lime, anhydrite & gyp	1956	
lime & anhydrite	1994	
shale, gyp, shells	2044	
lime, anhydrite, shale	2122	
shale strks lime	2215	
shale & shells	2369	
shale	2372	
shale & shells	2737	
shale & lime	2823	
shale & shells	2900	
lime & shale	2986	
shale & lime shells	3050	
lime & shale	3339	
lime sdv	3356	
lime gy hd	3362	
lime gy	3367	
lime gy hd	3378	
lime gy	3380	
shale blue	3384	
lime gy	3387	
lime gy hd	3403	
shale blue	3410	
lime gy (hole caving)	3411	
shale blue @3400)	3420	
lime gy	3423	
lime	3466	
lime & shale	3487	
conglomerate	3528	
Total Depth.		

PLUGGING
FILE # 29 20, 13W
BOOK PAGE 14 LINE 33