

15.009.05660.0000

STATE OF KANSAS
STATE CORPORATION COMMISSION

Give All Information Completely
Make Required Affidavit
Mail or Deliver Report to:
Conservation Division
State Corporation Commission
800 Bitting Building
Wichita, Kansas

WELL PLUGGING RECORD

Barton County. Sec. 29 Twp. 20 Rge. 13 (E) W (W)
NE SE NW

Location as "NE/CNW/SW" or footage from lines _____
Lease Owner Graybol Contracting Corporation

Lease Name Murphy Well No. 6

Office Address 523 Petroleum Building - Wichita 2, Kansas

Character of Well (completed as Oil, Gas or Dry Hole) Dry Hole

Date well completed August 25 19 53

Application for plugging filed August 25 19 53

Application for plugging approved August 25 19 53


Plugging commenced August 25 19 53

Plugging completed August 25 19 53

Reason for abandonment of well or producing formation Dry

If a producing well is abandoned, date of last production _____ 19 _____

Was permission obtained from the Conservation Division or its agents before plugging was commenced? Yes

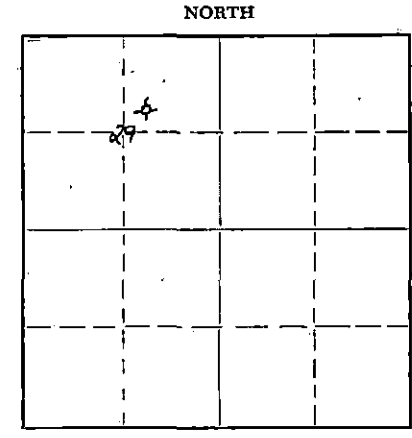

Locate well correctly on above Section Plat

Name of Conservation Agent who supervised plugging of this well C. D. Stough

Producing formation _____ Depth to top _____ Bottom _____ Total Depth of Well 3520 Feet

Show depth and thickness of all water, oil and gas formations.

OIL, GAS OR WATER RECORDS				CASING RECORD		
FORMATION	CONTENT	FROM	TO	SIZE	PUT IN	PULLED OUT
				8-5/8"	136'	None

Describe in detail the manner in which the well was plugged, indicating where the mud fluid was placed and the method or methods used in introducing it into the hole. If cement or other plugs were used, state the character of same and depth placed, from _____ feet to _____ feet for each plug set.

Jetted pits and filled hole to 136'
Set plug with 1/3 Sack Hulls at 136'
and 25 Sacks Cement.
Set plug No. 2 at 40' with 1/3 Sack
Hulls and filled above with 10 Sacks
Cement.

(If additional description is necessary, use BACK of this sheet)

Name of Plugging Contractor Graybol Contracting Corporation
Address 523 Petroleum Building - Wichita 2, Kansas

STATE OF Kansas, COUNTY OF Sedgwick, ss.
A. N. Ward, Vice-President (employee of owner) or (owner or operator) of the above-described well, being first duly sworn on oath, says: That I have knowledge of the facts, statements, and matters herein contained and the log of the above-described well as filed and that the same are true and correct. So help me God.

(Signature) [Signature]

523 Petroleum Building - Wichita 2, Kansas
(Address)

SUBSCRIBED AND SWORN to before me this 25th day of August, 19 53

[Signature]
Notary Public.

My commission expires My Commission Expires Oct. 31, 1955

24-2675-S 2-52-20M

PLUGGING
FILE SEC 29 T 20 R 13W
BOOK PAGE 15 LINE 23

CONSERVATION DIVISION
Wichita, Kansas
8-31-53

GRAYBOL CONTRACTING CORPORATION & L. B. SMITH

MURPHY # 6

NE SE NW Sec. 29-20-13
Barton County, Kansas

Comm. Drlg. : 8-15-53
Completed Drlg. : 8-25-53
Total Depth : 3520'
Completed : 8-25-53

Elevation : 1895 R. B.
Initial Prod. : D & A
Contractor : Graybol
Tools : Rotary

CASING RECORD

Run 136' 8-5/8" Surface Casing
Cemented with 175 Sacks Cement
Left in Hole 136' 8-5/8" Casing

STRATA	DEPTH	FORMATION	ROTARY BUSHING TOP
Surface Soil and Clay	15	Anhydrite	754' (- 1111)
Sand	115	Heebner	3098' (- 1203)
Shale and Shells	134	Brown Lime	3214' (- 1319)
Hard Sand	160	Lansing	3225' (- 1330)
Sand and Shale Streaks	400	Conglomerate	3444' (- 1549)
Red Bed and Shale	425	Granite Wash	3514' (- 1619)
Red Bed	754	Granite	3519' (- 1624)
Anhydrite	775	TOTAL DEPTH	3520' (- 1625)
Shale and Shells	1200		
Salt	1430		
Lime and Shale	1530		
Lime	1620	Show of Oil 3312' - 3320'	
Lime and Shale	1680		
Lime	1770		
Lime and Shale	2105	Drill Stem Test # 1 - 3304' to 3321'	
Lime	2160	Open 1 hour. Fair blow - recovered 70' Gas,	
Lime and Shale	2845	20' slightly Oil Cut Mud and 48' slightly Oil	
Lime	3105	Cut Salt Water. I. F. P. 90#. F. F. P. 120#.	
Shale and Lime	3215	B. H. P. 470# in 15 minutes.	
Lime	3405		
Lime and Shale	3475	Show of Oil 3383' - 3390'	
Conglomerate	3514		
Granite Wash	3519	Drill Stem Test # 2 - 3374' to 3395'	
Granite	3520	Open 30 minutes. Weak blow for 12 minutes -	
TOTAL DEPTH	3520	recovered 12' Mud slightly Oil specked. B. H.	
		P. 0# in 15 minutes.	

GRAYBOL CONTRACTING CORPORATION

By Charles A. Roberts

STATE OF KANSAS)
COUNTY OF SEDGWICK)

Subscribed and sworn to before me this 26th day of August, 1953.

My Commission Expires Oct. 31, 1956

Charles A. Roberts
Notary Public

PLUGGING
FILE SEC 29-20-13
BOOK PAGE 125 LINE 23