


STATE OF KANSAS  
STATE CORPORATION COMMISSION

## WELL PLUGGING RECORD

Give All Information Completely  
Make Required Affidavit  
Mail or Deliver Report to  
Conservation Division  
State Corporation Comm.  
245 North Water  
Wichita, KS 67202

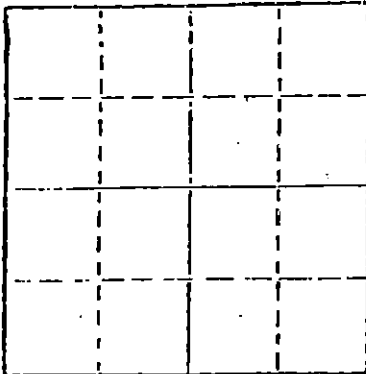

Locate well correctly on above  
Section Plot

Barton County, Sec. 29 Twp. 20 Rge. 13 XX/W  
Location as "NE/CNW $\frac{1}{2}$ SW $\frac{1}{2}$ " or footage from lines SE SE NE

Lease Owner Robinowitz Oil Company  
Lease Name Ingelman Well No. 4  
Office Address 6650 South Lewis, Tulsa, OK 74136  
Character of Well (Completed as Oil, Gas or Dry Hole) Dry Hole

Date Well completed 11-28 19 80  
Application for plugging filed 11-28 19 80  
Application for plugging approved 11-28 19 80  
Plugging commenced 11-28 19 80  
Plugging completed 11-28 19 80  
Reason for abandonment of well or producing formation Dry Hole

If a producing well is abandoned, date of last production 19

Was permission obtained from the Conservation Division or its agents before plugging was commenced? Yes

Name of Conservation Agent who supervised plugging of this well Duane Rankin  
Producing formation Depth to top Bottom Total Depth of Well  
Show depth and thickness of all water, oil and gas formations.

## OIL, GAS OR WATER RECORDS

## CASING RECORD

| FORMATION | CONTENT | FROM | TO | SIZE   | PUT IN | PULLED OUT |
|-----------|---------|------|----|--------|--------|------------|
|           |         |      |    | 8-5/8" | 297    | -0-        |
|           |         |      |    |        |        |            |
|           |         |      |    |        |        |            |
|           |         |      |    |        |        |            |

Describe in detail the manner in which the well was plugged, indicating where the mud fluid was placed and the method or methods used in introducing it into the hold. If cement or other plugs were used, state the character of same and depth placed, from feet to feet for each plug set.

Mud laden fluid 3451-297'

50 sks cement @ 480'

30 sks cement @ 370'

10 sks cement @ 40'

10 sks cement in rat hole

(If additional description is necessary, use BACK of this sheet)

Name of Plugging Contractor Emphasis Oil Operations

STATE OF Kansas COUNTY OF Russell  
Joe K. Branum (employee of owner) or owner or operator  
of the above-described well, being first duly sworn on oath, says: That I have knowledge of the facts, statements, and matters herein contained and the log of the above-described well as filed and that the same are true and correct. So help me God.

(Signature) Joe K. Branum


P.O. Box 506, Russell, KS 67665

(Address)

SUBSCRIBED AND SWORN TO before me this 4th day of December, 19 80

My commission expires February 6, 1984

Glenda R. Tiffin Notary Public.

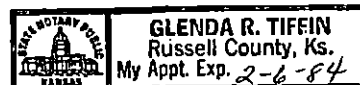

## EMPHASIS OIL OPERATIONS

P.O. Box 506

Russell, Kansas 67665

DRILLERS LOG

OPERATOR: Robinowitz Oil Company  
6650 South Lewis  
Tulsa, Oklahoma 74136

CONTRACTOR: Emphasis Oil Operations  
P. O. Box 506  
Russell, Kansas 67665

LEASE: Ingelman WELL: #4

LOCATION: SE SE NE  
Section 29-20-13  
Barton County, Kansas

Total Depth: 3451'

Elevation:

Commenced: 11-11-80

Completed: 11-28-80

Casing: 8-5/8" @ 297'

Status: Dry Hole


DEPTHS & FORMATIONS

(All measurements from K.B.)

|                |     |                       |      |
|----------------|-----|-----------------------|------|
| Sand & clay    | 60  | Shale                 | 1800 |
| Shale & sand   | 340 | Shale & lime          | 2743 |
| Shale & shells | 940 | Lime & shale (R.T.D.) | 3451 |

STATE OF KANSAS )  
COUNTY OF RUSSELL ) ss


I, Joe K. Branum, of Emphasis Oil Operations, state that the above and foregoing is a true and correct log of the above captioned well.

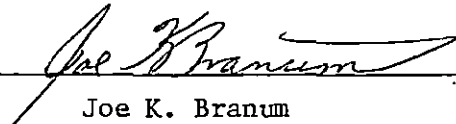  
Joe K. Branum

Subscribed and sworn to before me this 4th day of December, 1980.

My Commission Expires: February 6, 1984.

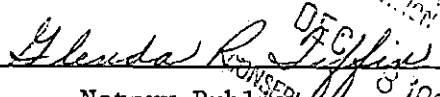

  
Notary Public  
Conservation Division  
Wichita, Kansas  
RECEIVED  
DEC 8 1980