

Give All Information Completely
Make Required Affidavit
Mail or Deliver Report to:
Conservation Division
State Corporation Commission
212 No. Market
Wichita, Kansas

WELL PLUGGING RECORD

Barton County. Sec. 29 Twp. 20 Rge. 13 (E) W (W)

Location as "NE/CNW/SW" or footage from lines SW NE NW

Lease Owner Joe Brougher Oil Company

Lease Name Murphy Well No. #1

Office Address 5513 Apache Great Bend, Kansas 67530

Character of Well (completed as Oil, Gas or Dry Hole) _____

Date well completed _____ 19____

Application for plugging filed May 13 1969

Application for plugging approved May 16 1969


Plugging commenced August 11 1969

Plugging completed August 18 1969

Reason for abandonment of well or producing formation _____

If a producing well is abandoned, date of last production _____ 19____

Was permission obtained from the Conservation Division or its agents before plugging was commenced? Yes

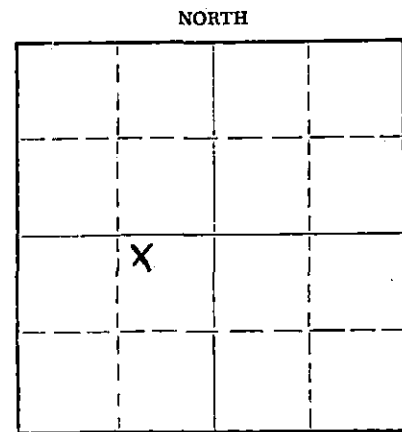

Locate well correctly on above Section Plat

Name of Conservation Agent who supervised plugging of this well Don Truan

Producing formation _____ Depth to top _____ Bottom _____ Total Depth of Well _____ Feet

Show depth and thickness of all water, oil and gas formations.

OIL, GAS OR WATER RECORDS

CASING RECORD

FORMATION	CONTENT	FROM	TO	SIZE	PUT IN	PULLED OUT
				8 5/8	132	None
				5 1/2	3438	1738

Describe in detail the manner in which the well was plugged, indicating where the mud fluid was placed and the method or methods used in introducing it into the hole. If cement or other plugs were used, state the character of same and depth placed, from _____ feet to _____ feet for each plug set.

8 - 11 - 69 Set Baker Cast Iron bridge plug at 3170'. Dumped sand to 3130'. Mixed and dumped 5 sx of cement to 3090', to plug off bottom.

8 - 18 - 69 Mixed and pumped 5 sx of hulls and 20 sx of gel down 8 5/8 casing. Released 8 5/8 plug. Mixed and pumped 100 sx of cement containing 6% gel down 8 5/8 casing.

RECEIVED
STATE CORPORATION COMMISSION
NOV 25 1969
CONSERVATION DIVISION
Wichita, Kansas

(If additional description is necessary, use BACK of this sheet)
Name of Plugging Contractor Russ Casing Pulling, Inc.
Address P. O. Box 1082 Great Bend, Kansas 67530

STATE OF Kansas, COUNTY OF Barton, ss.
Joe Brougher (employee of owner) or (owner or operator) of the above-described

well, being first duly sworn on oath, says: That I have knowledge of the facts, statements, and matters herein contained and the log of the above-described well as filed and that the same are true and correct. So help me God.

(Signature) Joe Brougher
5513 Apache, Great Bend, Ka. (Address)

SUBSCRIBED AND SWORN TO before me this 24th day of November, 1969.

My commission expires May 2, 1970
Ruby Brown Notary Public.

RECEIVED
STATE CORPORATION COMMISSION
MAY 15 1969
CONSERVATION DIVISION
Wichita, Kansas

GRAYBOL CONTRACTING CORP. & L. B. SMITH

MURPHY # 5

SW NE NW Sec. 29-20-13
Barton County, Kansas

Comm. Drlg. : 8-4-53
Completed Drlg. : 8-14-53
Total Depth : 3419'
Completed :

Elevation : 1892 R. B.
Initial Prod. :
Contractor : Graybol
Tools : Rotary

CASING RECORD

<u>Run</u>		<u>Left in Hole</u>
132'	8-5/8" surface casing Cement with 175 sacks Cement	132' 8-5/8" casing
3438'	5-1/2" casing Cement with 60 sacks Cement	3438' 5-1/2" casing.

STRATA	DEPTH	FORMATION	ROTARY BUSHING TOP
Sand and Clay	25	Heebner Shale:	3075' (-1183)
Sand	110	Toronto :	3097' (-1205)
Blue Shale	120	Douglas :	3107' (-1215)
Hard Sand	164	Brown Lime :	3188' (-1296)
Blue Shale and Sand	280	Lansing :	3198' (-1306)
Sand and Gypsum	310	Granite :	3416' (-1524)
Red Bed	730	TOTAL DEPTH:	3419' (-1527)
Blue Shale	745		
Gypsum	755		
Anhydrite	778		
Shale and Shells	1220	Show of Oil 3354' - 3359'	
Salt	1450		
Lime and Shale	1925		
Lime	1960	Drill Stem Test - 3347' to 3362'	
Lime and Shale	2200	Open 30 minutes. Good blow - Gas to surface in	
Lime	2225	17 minutes. Recovered 240' Gassy, Froggy Oil.	
Shale and Lime	2675	B. H. P. 870# in 20 minutes.	
Lime	2730		
Shale and Lime	2826		
Lime	3125		
Lime and Shale	3188		
Lime	3416		
Granite	3419		
RTD	3419		

GRAYBOL CONTRACTING CORPORATION

By [Signature]

STATE OF KANSAS)
COUNTY OF SEDGWICK)

Subscribed and sworn to before me this 17th day of August, 1953.

My Commission Expires Oct. 31, 1955

[Signature]
Notary Public