

15.009.21400.0000


STATE OF KANSAS
STATE CORPORATION COMMISSION

WELL PLUGGING RECORD

Give All Information Completely
Make Required Affidavit
Mail or Deliver Report to
Conservation Division
State Corporation Comm.
245 North Water
Wichita, KS 67202

Barton County, Sec. 29 Twp. 20 Rge. 13 E/W
Location as "NE/CNW 1/4 SW 1/4" or footage from lines NE SE SE

Lease Owner Bill Witcraft
Lease Name SWADER Well No. 1
Office Address Box 811 - Great Bend, Ks, 67530
Character of Well (Completed as Oil, Gas or Dry Hole) Dry Hole

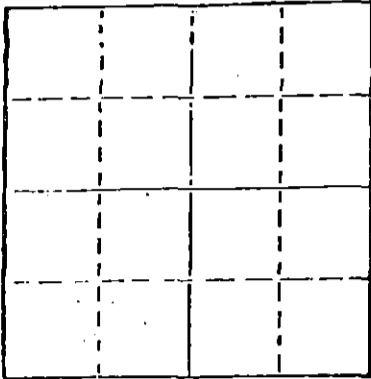

Locate well correctly on above
Section Plot

Date Well completed June 21 19 78
Application for plugging filed June 21 19 78
Application for plugging approved June 21 19 78
Plugging commenced June 21 19 78
Plugging completed June 21 19 78
Reason for abandonment of well or producing formation _____

If a producing well is abandoned, date of last production 19 _____

Was permission obtained from the Conservation Division or its agents before plugging was commenced? yes

Name of Conservation Agent who supervised plugging of this well Duane Rankin
Producing formation _____ Depth to top _____ Bottom _____ Total Depth of Well 3625
Show depth and thickness of all water, oil and gas formations.

OIL, GAS OR WATER RECORDS

CASING RECORD

FORMATION	CONTENT	FROM	TO	SIZE	PUT IN	PULLED OUT

Describe in detail the manner in which the well was plugged, indicating where the mud fluid was placed and the method or methods used in introducing it into the hold. If cement or other plugs were used, state the character of same and depth placed, from _____ feet to _____ feet for each plug set.

Bottom plug @ 450' with 50 sacks cement thru drill pipe
Middle plug at 210' with 25 sacks cement thru drill pipe
Top plug @ 40' with 1/2 sack hulls & 10 sacks cement.
2 sacks cement in rat hole.

JUN 26 1978 6-26-78

DIVISION
Wichita, Kansas

(If additional description is necessary, use BACK of this sheet)

Name of Plugging Contractor Duke Drilling Co., Inc.
Box 823 - Great Bend, Ks, 67530

STATE OF Kansas COUNTY OF Barton, ss.
Leonard Williamson (employee of owner) or ~~(owner or operator)~~
of the above-described well, being first duly sworn on oath, says: That I have knowledge of the facts, statements, and matters herein contained and the log of the above-described well as filed and that the same are true and correct. So help me God.

(Signature) Leonard Williamson
Box 823 - Great Bend, Ks, 67530
(Address)

SUBSCRIBED AND SWORN TO before me this 23 day of June, 19 78

Deborah M. Hague
Notary Public.

My commission expires 4-11-1982



DRILLERS WELL LOG

DATE COMMENCED: June 15, 1978
DATE COMPLETED: June 21, 1978

Bill Witcraft
SWADER #1
NE SE SE of Sec 29-T20-R13W
Barton County, Kansas

0 - 135'	Surface Soil, Sand & Shale
135 - 206'	Sand
206 - 300'	Shale & Sand
300 - 773'	Shale & Red Bed
773 - 795'	Anhydrite
795 - 1575'	Shale & Red Bed
1575 - 1810'	Shale & Lime Streaks
1810 - 3157'	Lime & Shale
3157 - 3161'	Shale
3161 - 3177'	Lime & Shale
3177 - 3197'	Lime
3197 - 3277'	Shale
3277 - 3290'	Lime & Shale
3290 - 3500'	Lime
3500 - 3510'	Lime & Shale
3510 - 3625'	Lime, Shale, Chert
3625'	RTD

ELEVATION: 1894 KB

FORMATION DATA	
ANHYDRITE	773
HERRINER	3157
TORONTO	3177
DOUGLAS	3197
BR. LIME	3277
KANSAS CITY	3290
BASE K.C.	3500
CONGLOMERATE	3510
RTD	3625

RECEIVED
STATE CORPORATION COMMISSION
JUN 26 1978
CONSERVATION DIVISION
Wichita, Kansas

SURFACE PIPE: Set used 28#
8-5/8" pipe at 230' with 190
sacks 50/50 pozmix, 2% Gel, 3%
cc.

AFFIDAVIT

STATE OF KANSAS
COUNTY OF BARTON) ss.

Leonard Williamson, of lawful age does swear and state that the facts and
statements herein contained are true and correct to the best of his knowledge.

Leonard Williamson

Subscribed and sworn to before me this 23 day of June 1978.

My Comm. Expires: 4-11-1982

Glenn M. Hague
Notary Public