


Give All Information Completely
Make Required Affidavit
Mail or Deliver Report to:
Conservation Division
State Corporation Commission
800 Bittling Building
Wichita, Kansas

WELL PLUGGING RECORD

NORTH

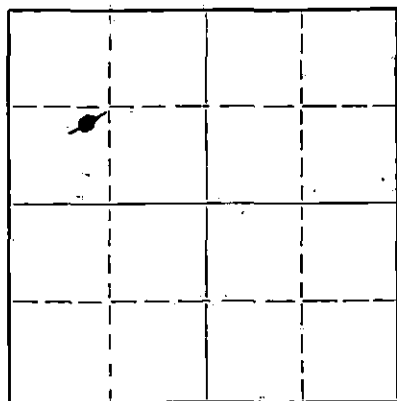

Locate well correctly on above Section Plat

Barton County, Sec. 32 Twp. 20 Rge. 13 (E) (W)
Location as "NE/CNW/SW" or footage from lines NE SW NW
Lease Owner Ben F. Brack Oil Company, Inc.
Lease Name Hartman Well No. 3
Office Address 309 Brown Bldg., Wichita, Kansas
Character of Well (completed as Oil, Gas or Dry Hole) oil
Date well completed 10-11-50 19
Application for plugging filed 5-21-53 19
Application for plugging approved 5-21-53 19
Plugging commenced 5-22-53 19
Plugging completed 5-25-53 19
Reason for abandonment of well or producing formation uneconomical - amount of oil not sufficient to continue production
If a producing well is abandoned, date of last production 4-10 19 53
Was permission obtained from the Conservation Division or its agents before plugging was commenced? Yes

Name of Conservation Agent who supervised plugging of this well C. D. Stough
Producing formation Arbuckle Depth to top 3527 Bottom 3551 Total Depth of Well 3551 Feet
Show depth and thickness of all water, oil and gas formations.

OIL, GAS OR WATER RECORDS

CASING RECORD

FORMATION	CONTENT	FROM	TO	SIZE	PUT IN	PULLED OUT
Surface soil, sand & gravel	dry	0	307	8 5/8"	307'	None
Kansas City Lime		3284	3521			
Conglomerate		3521	3527			
Arbuckle		3527	3551	5 1/2"	3528'	2040'

Describe in detail the manner in which the well was plugged, indicating where the mud fluid was placed and the method or methods used in introducing it into the hole. If cement or other plugs were used, state the character of same and depth placed, from _____ feet to _____ feet for each plug set.

Plugged back from 3552-3500' with sand, plugged back from 3500'-3475' with 5 sax cement. Shot pipe @ 2040'. Pumped in 30 sax Magcogel and 60 sax cement. Squeezed 8 5/8" surface pipe with 40 sax cement.

RECEIVED 5-28-1953
STATE CORPORATION COMMISSION
MAY 28 1953
CONSERVATION DIVISION
Wichita, Kansas

(If additional description is necessary, use BACK of this sheet)
Name of Plugging Contractor Pipe Pulling, Inc.
Address 629 W. Broadway, Stafford, Kansas

STATE OF KANSAS, COUNTY OF SEDGWICK, ss.
Leland E. Brack (employee of owner) of the above-described well, being first duly sworn on oath, says: That I have knowledge of the facts, statements, and matters herein contained and the log of the above-described well as filed and that the same are true and correct. So help me God.

(Signature) Leland E. Brack
309 Brown Building, Wichita, Kansas (Address)

SUBSCRIBED AND SWORN to before me this 26th day of May, 1953
Gertrude Crist
Notary Public.



PLUGGING
FILE SEC 32 T 20 R 13W
BOOK PAGE 101 LINE 14

BEN F. BRACK OIL COMPANY, INC.
 309-10 BROWN BUILDING
 WICHITA, KANSAS.

HARTMAN #3

NE SW NW

Sec. 32, T. 20, R. 13
 Barton County, Kansas.

DAILY DRILLING REPORT AND WELL LOG

COMMENCED: September 28, 1950

Completed: October 11, 1950

TOTAL DEPTH: 3529

Cellar	5'	
Surface soil and sand	120	
Iron	140	8-5/8" surface pipe cemented with 300 sacks of cement at 307'
Iron	152	
Sand and Shale	315	
Sand and Red Bed	330	
Red Bed	500	
Red Bed	780	
Anhydrite	870	
Red Bed and Shale	930	
Red Bed	1155	
Shale	1250	
Shale and Red Bed	1360	
Salt	1545	
Shale and Shells	1570	
Shale and Lime	1815	
Lime and Shale	1955	
Lime	2045	
Lime and Shale	2135	
Lime and Shale breaks	2220	
Lime and Shale	2305	
Lime and Shale breaks	2435	
Shale and Shells	2580	
Shale and Lime	2675	
Lime - Broken	2755	
Shale and Lime	2935	
Lime	3000	
Lime	3115	
Lime	3160	
Lime and Shale	3235	
Lime - Kansas City Lansing	3295	
KANSAS CITY LANSING TOP	3284	
Lime	3345	
Lime	3390	5 1/2" Casing cemented with 100 sacks of cement at 3525'.
Lime	3415	
Lime	3453	
Lime	3460	
Lime	3505	
Lime	3529	
TOTAL DEPTH	3529	

RECEIVED
 STATE CORPORATION COMMISSION
 MAY 15 1953

To the best of my knowledge the
 above is a true and correct
 statement of formations and where
 found.

WITNESS: CONSERVATION DIVISION
 Wichita, Kansas

BEN F. BRACK OIL COMPANY, INC.

L. W. Feldt

By *Henry Brack*
 Vice-President

PLUGGING

WELL SEC 32 T 20 R 13 W

Dated: November 3, 1950

BOOK PAGE 104 LINE 14

8-5/8" surface pipe
 cemented with 300 sacks
 of cement at 307'