


STATE OF KANSAS
STATE CORPORATION COMMISSION
CONSERVATION DIVISION
P. O. BOX 17027
WICHITA, KANSAS 67217

FORM CP-4

WELL PLUGGING RECORD

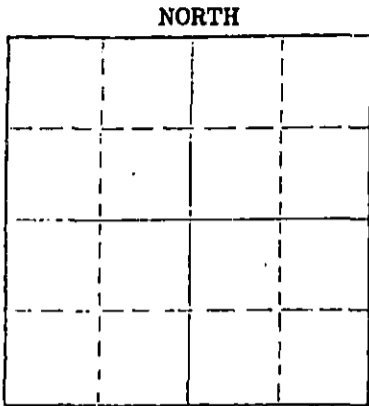

Locate well correctly on above Section Plat

Barton County. Sec. 32 Twp. 20S Rge. 13W (EX (W)
Location as "NE/CN\W&SW" or footage from lines NE NW SW
Lease Owner H. A. Chapman Investments
Lease Name Wright #1 Well No. 1
Office Address 404 Cities Service Building, Tulsa, Oklahoma 74119
Character of Well (completed as Oil, Gas or Dry Hole) Dry Hole
Date well completed February 4, 1976 19
Application for plugging filed February 4, 1976 19
Application for plugging approved February 4, 1976 19
Plugging commenced 1:00 PM, February 4, 1976 19
Plugging completed 3:00 PM, February 4, 1976 19
Reason for abandonment of well or producing formation Dry Hole

If a producing well is abandoned, date of last production 19
Was permission obtained from the Conservation Division or its agents before plugging was commenced? Yes

Name of Conservation Agent who supervised plugging of this well Tuane Rankin
Producing formation Depth to top Bottom Total Depth of Well 3605' Feet
Show depth and thickness of all water, oil and gas formations.

OIL, GAS OR WATER RECORDS				CASING RECORD		
FORMATION	CONTENT	FROM	TO	SIZE	PUT IN	PULLED OUT
				8 5/8"	323.10	None

Describe in detail the manner in which the well was plugged, indicating where the mud fluid was placed and the method or methods used in introducing it into the hole. If cement or other plugs were used, state the character of same and depth placed, from feet to feet for each plug set.

Filled hole with heavy mud.
40 sacks 50/50 Pozmix at 500' through open
end drillpipe; 25 sacks at 330'; filled
hole up to 40', solid bridge, 10 sacks
cement. 2 sacks in rathole.

(If additional description is necessary, use BACK of this sheet)
Name of Plugging Contractor Sterling Drilling Company
Address P. O. Box 129, Sterling, Kansas 67579

STATE OF KANSAS COUNTY OF RICE SS.
F. A. Wuellner (employee of owner) or (owner or operator) of the above-described

well being first duly sworn on oath, says: That I have knowledge of the facts, statements, and matters herein contained and the log of the above-described well as filed and that the same are true and correct. So help me God. **STERLING DRILLING COMPANY**

(Signature) [Signature]
F. A. Wuellner, Secretary
P. O. Box 129, Sterling, Kansas 67579
(Address)

Subscribed and sworn to before me this 7th day of February, 1976



CHARLES HALL—NOTARY PUBLIC
My Commission Expires Jan 6 1978
[Signature]
Charles M. Hall, Notary Public.

RECEIVED
STATE CORPORATION COMMISSION
FEB 10 1976
CONSERVATION DIVISION
Wichita, Kansas

15.009.20962.0000

STERLING DRILLING COMPANY
P. O. Box 129
Sterling, Kansas 67579

WELL LOG ----- Wright #1
Located: NE NW SW, Section 32-20S-13W, Barton County,
Kansas

OWNER: H. A. Chapman Investments
ROTARY DRILLING CONTRACTOR: Sterling Drilling Company

COMMENCED: December 23, 1975
COMPLETED: February 4, 1976

TOTAL DEPTH: 3605'

<u>LOC</u>	<u>CASING RECORD</u>
0 - 125 Gravel	Ran 10 joints 8 5/8" casing, 323.10' set at 2' below G.L. Cemented with 225 sacks Pozmix with 2% cc. Plug down at 6:45 AM, 12-24-75.
125 - 165 Sand and Gravel	
165 - 305 Shale	
305 - 788 Red Bed	
788 - 812 Anhydrite	
812 - 1075 Shale and Shells	
1075 - 3290 Lime and Shale	
3290 - 3605 Lime	Plugged.

RECEIVED
STATE CORPORATION COMMISSION
FEB 10 1976
CONSERVATION DIVISION
Wichita, Kansas