

STATE OF KANSAS
STATE CORPORATION COMMISSION


Give All Information Completely
Make Required Affidavit
Mail or Deliver Report to:
Conservation Division
State Corporation Commission
800 Bittling Building
Wichita, Kansas

WELL PLUGGING RECORD

BARTON

County. Sec. 32 Twp. 20 Rge. 13 (E) (W) ES

Location as "NE/CNW/4SW/4" or footage from lines
BEN F. BRACK OIL CO INC.
Lease Owner
Lease Name HARTMAN Well No. L
Office Address 309-10 BROWN BLDG. WICHITA, KANSAS.
Character of Well (completed as Oil, Gas or Dry Hole) DRY HOLE
Date well completed 2-12 19 49
Application for plugging filed 7-15-49 19
Application for plugging approved 7-15-49 19
Plugging commenced 7-15-49 19
Plugging completed 7-15-49 19
Reason for abandonment of well or producing formation DRY HOLE

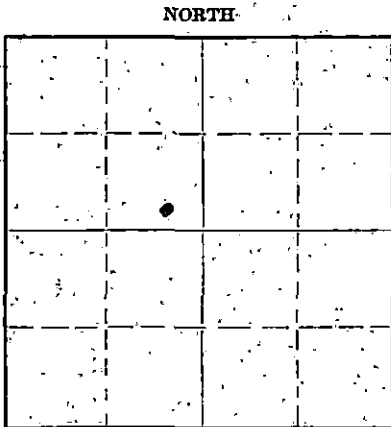

Locate well correctly on above.
Section Plat

If a producing well is abandoned, date of last production 19
Was permission obtained from the Conservation Division or its agents before plugging was commenced? YES

Name of Conservation Agent who supervised plugging of this well C.D. STOUGH
Producing formation NONE
Depth to top Bottom Total Depth of Well Feet
Show depth and thickness of all water, oil and gas formations.

OIL, GAS OR WATER RECORDS

CASING RECORD

Formation	Content	From	To	Size	Put In	Pulled Out
SURFACE SOIL SNAD SHALES, IRON	0	0	146'	8 5/8	145	none
ar buckle	dry	3600	3689	5 1/2	3600	2270'

Describe in detail the manner in which the well was plugged, indicating where the mud fluid was placed and the method or methods used in introducing it into the hole. If cement or other plugs were used, state the character of same and depth placed, from 145' feet to feet for each plug set.

SET PLUG AT 145' PUMPED IN 60 SAX CEMENT BY HALLIBURTON. CEMENT CAME TO 10 FEET FROM CELLAR.

RECORDED

AUG 4 - 1949

8-4-1949

STATE CORPORATION COMMISSION

KANSAS

(If additional description is necessary, use BACK of this sheet)

Correspondence regarding this well should be addressed to BEN F. BRACK OIL CO INC.
Address 309-10 BROWN BLDG.
WICHITA, KANSAS.

STATE OF KANSAS COUNTY OF SEDGWICK, ss.
OSCAR W. TEMPS

(employee of owner) or (owner or operator) of the above-described well, being first duly sworn on oath, says: That I have knowledge of the facts, statements, and matters herein contained and the log of the above-described well as filed and that the same are true and correct. So help me God.

(Signature) Oscar W. Temps
309-10 Brown Bldg.
(Address)

SUBSCRIBED AND SWORN to before me this 15 day of July, 1949.

My commission expires November 5, 1951

Notary Public.

PLUGGING
FILE SEC 32 T 20 R 13
BOOK PAGE 105 LINE 39

BEN F. BRACK OIL COMPANY, INC.
 310 BROWN BUILDING
 WICHITA, KANSAS

HARTMAN #1 SE SE NW Section 32, Township 20 S., R. 13 West,
 BARTON COUNTY, KANSAS

 WELL LOG

TOTAL DEPTH 3603

Comm: 1-11-49 Comp: 1-27-49

Cellar	5'
Iron	130
Iron & Shale	146
Iron	154
Iron	157
Blue Clay	230
Sand	320
Clay and Red Bed	750
Red Bed	785
Anhydrite	820
Red Bed and Shale	1135
Shale and Shells	1335
Salt and Shale	1550
Shale & Lime	1680
Lime and Shale	1800
Lime and Shale Streaks	1900
Lime and Shale	2000
Lime and Shale	2105
Lime and Shale	2240
Lime and Shale	2360
Broken Lime and Shale	2485
Shale	2615
Shale and Lime	2705
Shale and Brown Lime	2820
Lime and Shale	2915
Shale and Lime	3020
Lime	3067
Lime	3130
Lime	3185
Lime and Shale	3270
Shale and Lime	3320
Lime	3354
Lime	3410
Lime	3433
Lime	3438
Lime	3445
Lime	3494
Lime	3495
Lime and Shale	3545
Lime and Shale	3565
Shale and Lime	3603
TOTAL DEPTH	3603

RECEIVED
 AUG 4 - 1949
 ST. LOUIS, MISSOURI

Dated: February 3, 1949

Witness: *Pauline Hendrickson*

To the best of my knowledge the above is a true and correct record of the formations and depths at which found.

BEN F. BRACK OIL COMPANY, INC.

By *B. F. Brack*
 President

PLUGGING
 FILE SEC 32 T 20 R 13a
 PAGE 105 LINE 39