

STATE OF KANSAS
STATE CORPORATION COMMISSION

Give All Information Completely
Make Required Affidavit
Mail or Deliver Report to:
Conservation Division
State Corporation Commission
800 Bittling Building
Wichita, Kansas

WELL PLUGGING RECORD OR FORMATION PLUGGING RECORD

**Strike out upper line
when reporting plug-
ging off formations.**

NORTH

**Locate well correctly on above
Section Plat**

Kiowa County. Sec. 14 Twp. 30 Rge. (E) 16 (W)

Location as "NE $\frac{1}{4}$ NW $\frac{1}{4}$ SW $\frac{1}{4}$ " or footage from lines:.....CSW NW.....

Lease Owner.....The Superior Oil Company.....

Lease Name Wright Well No 1

Office Address 417 First National Bank Building

Character of Well (completed as Oil, Gas or Dry Hole)..... Dry Hole

Date well completed.....August 2, 1943.....19.....

Application for plugging filed..... August 2 1943

Application for plugging approved.....19.....

Plugging commenced August 3 1943

Plugging completed August 3 1943

Reason for abandonment of well or producing formation..... Dry Hole.....

.....

If a producing well is abandoned, date of last production _____ - 19____

Was permission obtained from the Conservation Division or its agents before plugging was com-

Was permission obtained from the Conservation Division of the agents before plugging was com-
menced? Yes

Name of Conservation Agent who supervised plugging of this well.....

Producing formation..... Depth to top..... Bottom..... Total Depth of Well..... Feet

Show depth and thickness of all water, oil and gas formations.

OIL, GAS OR WATER RECORDS

CASING RECORD


[illegible]

Describe in detail the manner in which the well was plugged, indicating where the mud fluid was placed and the method or methods used in introducing it into the hold. If cement or other plugs were used, state the character of same and depth placed, fromfeet tofeet for each plug set.

Surface pipe set 314'

Plug 312' to 272'

20' top plug in surface pipe.

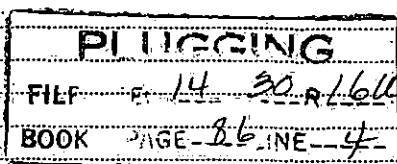

(If additional description is necessary, use BACK of this sheet)

Correspondence regarding this well should be addressed to The Superior Oil Company
Address 417 First National Bank Building, Wichita 2, Kansas

STATE OF _____, COUNTY OF _____ ss.

being first duly sworn on oath, says: That I have knowledge of the facts, statements, and matters herein contained and the log of the above-described well as filed and that the same are true and correct. So help me God.

(Signature)..... *H. H. Hall*

SUBSCRIBED AND SWORN to before me this 6th day of August 1943

My commission expires May 5 1945

THE SUPERIOR OIL COMPANY OF CALIFORNIA

Wright No. 1

Sec. 14-30-16W.
CSW NW

Total Depth 4915

Comm. 7-1-43 Comp.

County--Kiowa

CASING.

Elevation--1785


10 3/4" 314'

Production--Dry

Figures Indicate Bottom of Formations

clay and sand	41	soft lime	3968
sand rock & shale	70	lime	4221
sand & shale	100	soft lime	4231
red rock	150	lime	4328
sand & red rock	325	shale & lime	4355
red rock & sand		shale	4377
shale	390	shale & lime	4410
redbed & shale	665	shale & lime	4445
shale & shells	1320	lime	4453
shale & cherty lime	1350	lime & shale	4484
shale & shells	1430	shale	4510
shale & cherty lime	1450	lime	4516
shale & salt	1595	lime & chert	4533
shale & lime shells	1700	shale w. chert strks	4552
shale & anhydrite	1840	chert	4561
shale	1890	lime & chert	4579
shale & anhydrite	1960	lime	4585
broken lime	2030	sandy lime	4588
anhydrite	2090	brkn lime	4615
shale & lime hard	2135	lime	4645
brkn lime & shale	2285	lime w. chert strks	4668
sandy lime	2303	brkn lime	4679
sandy lime & shale	2370	shale	4717
brkn lime & shale	2430	cherty lime	4737
shale & lime	2505	chert	4742
sandy lime & shale	2520	shale w. chert strks	4774
lime & shale	2540	chert & lime	4782
brkn lime & shale	2615	cherty lime	4790
shale & lime	2645	shale w. sand strks	4819
shale & lime	2735	shale	4836
shale & lime shells	2820	shale & lime	4842
shale & lime shells	2870	shale	4886
lime & shale	2970	shale & lime	4904
shale & lime shells	3050	lime	4915
shale	3120		
shale & lime	3233	TOPS	
brkn lime	3260		
lime & shale	3304	Florence Flint	2325
lime	3510	Lansing	3938
brkn lime	3525	Penn. Sd.	4577
lime	3690	Viola	4590
brkn lime	3720	Simpson	4690
lime	3829	Arbuckle	4879
sandy lime	3835		
lime	3900		
lime & shale	3940		
brkn lime	3968		

I hereby certify that this is a true and accurate log
of the Wright No. 1, CSW NW, 14-30-16W, Kiowa County, Kan.

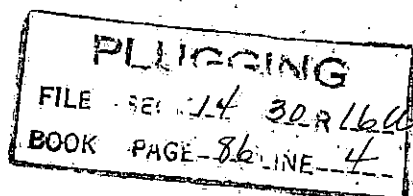

J. A. Mull
District Geologist

