


STATE OF KANSAS  
STATE CORPORATE COMMISSION

Form CP-4

WELL PLUGGING RECORD

Give All Information Completely  
Make Required Affidavit  
Mail or Deliver Report to:  
Conservation Division  
State Corporation Commission  
P. O. Box 17027  
Wichita, Kansas 67217  
NORTH

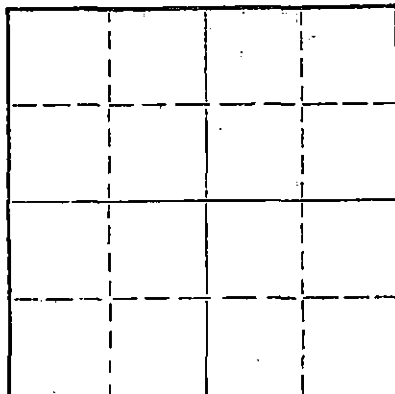

Locate well correctly on above  
Section Plat

Kiowa County, Sec. 14 Twp. 30 Rge. 16W (E) (W)  
Location as "NE/CNW/SW/" or footage from lines W/2 W/2 SE  
Lease Owner PICKRELL DRILLING COMPANY  
Lease Name ROBBINS-GALLUP "E" Well No. 1  
Office Address 705 4th National Bank Bldg. Wichita, Ks. 67202  
Character of Well (completed as Oil, Gas or Dry Hole) Dry Hole  
Date well completed 3-26 19 75  
Application for plugging filed 3-26 19 75  
Application for plugging approved 3-26 19 75  
Plugging commenced 3-26 19 75  
Plugging completed 3-26 19 75  
Reason for abandonment of well or producing formation Dry Hole

If a producing well is abandoned, date of last production 19  
Was permission obtained from the Conservation Division or its agents before plugging was commenced? Yes

Name of Conservation Agent who supervised plugging of this well G. R. Biberstein  
Producing formation \_\_\_\_\_ Depth to top \_\_\_\_\_ Bottom \_\_\_\_\_ Total Depth of Well 4890 Feet  
Show depth and thickness of all water, oil and gas formations.

OIL, GAS OR WATER RECORDS

CASING RECORD

FORMATION	CONTENT	FROM	TO	SIZE	PUT IN	PULLED OUT
				8 5/8	244	None
<b>RECEIVED</b> STATE CORPORATION COMMISSION APR 18 1975 CONSERVATION DIVISION Wichita, Kansas						

Describe in detail the manner in which the well was plugged, indicating where the mud fluid was placed and the method or methods used in introducing it into the hole. If cement or other plugs were used, state the character of same and depth placed, from \_\_\_\_\_ feet to \_\_\_\_\_ feet for each plug set.

30 sacks at 225'  
15 sacks Bridged at 40'  
2 sacks in Rat hole

Job completed 10:30AM 3/26/75.

(If additional description is necessary, use BACK of this sheet)  
Name of Plugging Contractor PICKRELL DRILLING COMPANY  
Address 705 4th National Bank Bldg. Wichita, Kansas 67202

STATE OF Kansas, COUNTY OF Sedgwick, ss.

C. W. Sebitts (employee of owner) or (owner or operator) of the above-described well, being first duly sworn on oath, says: That I have knowledge of the facts, statements and matters herein contained and the log of the above-described well as filed and that the same are true and correct. So help me God.

(Signature) C. W. Sebitts  
705 4th National Bank Bldg. Wichita, Ks. 67202  
(Address)

SUBSCRIBED AND SWORN TO before me this 31 day of March, 19 75

My commission expires August 19, 1975  
Helen L. Martin Notary Public.

HELEN L. MARTIN  
NOTARY PUBLIC  
Sedgwick County, Kans.  
My Comm. Expires Aug. 19, 1975

ROTARY DRILLING LOG

COMPANY: PICKRELL DRILLING COMPANY  
705 4th Nat'l. Bank Bldg.  
Wichita, Kansas 67202  
LOCATION: Robbins-Gallup "E" #1  
Approx. W/2 W/2 SE Sec. 14-30S-16W  
Kiowa County, Kansas  
CONTRACTOR: PICKRELL DRILLING COMPANY  
Wichita, Kansas

Rotary Drilling Commenced 3-12-75  
Rotary Drilling Completed 3-26-75

CASING RECORD: 8 5/8" surface casing set at 244 and cemented with 235 sacks cement.  
Job completed 3/13/75.

LOG

(Figures indicate bottom of formation — measurements from top of rotary bushing.)

Top soil	40	Lime	4650
Sand	100	Lime	4695
Red Beds	303	Lime	4752
Red Beds & Shale	380	Lime	4807
Red Beds & Shale	900	Lime & Shale	4861
Shale	1225	Arb. Top	4877
Shale & Shells	1310	Arb.	4890
Shale & Lime	1651		
Chert & Lime	1714		
Shale	1839		
Shale & Lime	1990		
Lime & Shale	2180		
Shale & Lime	2410		
Lime & Shale	2570		
Shale & Lime	2710		
Shale & Lime	2910		
Shale & Lime	3050		
Shale & Lime	3145		
Lime & Shale	3280		
Shale & Lime	3465		
Lime & Shale	3640		
Lime	3785		
Lime & Shale	3935		
Lime & Shale	4035		
Lime	4110		
Lime	4185		
Lime	4247		
Lime	4315		
Lime	4395		
Lime	4435		
Lime	4480		
Lime	4540		
Shale & Lime	4560		
Lime	4570		
Lime	4640		

RECEIVED  
STATE CORPORATION COMMISSION  
APR 18 1975  
CONSERVATION DIVISION  
Wichita, Kansas

The undersigned, C. W. Sebitts, Attorney-in-Fact for PICKRELL DRILLING COMPANY, hereby certifies in behalf of said Company, that the above is a true and correct log of the formation encountered in drilling the above well as reflected by the Daily Drilling Reports.

PICKRELL DRILLING COMPANY  
By C. W. Sebitts Attorney-in-Fact

STATE OF KANSAS }  
COUNTY OF SEDGWICK } ss.:

On this 31 day of March, 19 75, before me the undersigned, a Notary Public, in and for

the County and State aforesaid, personally appeared C. W. Sebitts, to me known to be the identical person who subscribed the name of PICKRELL DRILLING COMPANY to the foregoing instrument as its Attorney-in-Fact and acknowledged to me that he executed the same as his free and voluntary act and deed, and as the free and voluntary act and deed of such company, for the uses and purposes therein set forth.

Given under my hand and seal of office the day and year last above written.

HELEN L. MARTIN  
My commission expires: August 19, 1975  
Sedgwick County, Kans.  
My Comm. Expires Aug. 19, 1975

Helen L. Martin  
Notary Public  
Helen L. Martin