


STATE OF KANSAS  
STATE CORPORATION COMMISSION

Give All Information Completely  
Make Required Affidavit  
Mail or Deliver Report to:  
Conservation Division  
State Corporation Commission  
212 No. Market  
Wichita, Kansas

WELL PLUGGING RECORD

NORTH

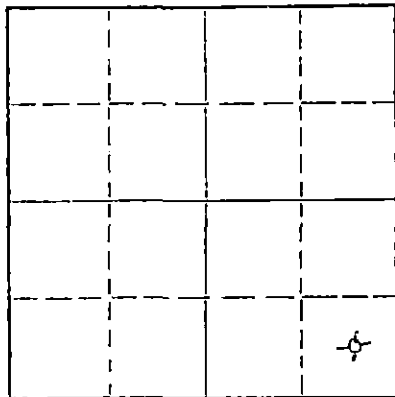

Locate well correctly on above  
Section Plat

Ness County, Sec. 36 Twp. 20S Rge. (E) 21W(W)  
Location as "NE/CNW\*SW\*" or footage from lines 150' NE OF SE $\frac{1}{4}$  SE $\frac{1}{4}$   
Lease ~~XXXX~~ Operator: Pickrell Drilling Company  
Lease Name Miner "F" Well No. 2  
Office Address 705 Fourth National Bldg., Wichita, Kansas, 67202  
Character of Well (completed as Oil, Gas or Dry Hole) Dry Hole  
Date well completed March 14, 19 68  
Application for plugging filed (verbally approved) March 19, 19 68  
Application for plugging approved (verbally approved) 19  
Plugging commenced March 14, 19 68  
Plugging completed March 14, 19 68  
Reason for abandonment of well or producing formation

If a producing well is abandoned, date of last production 19  
Was permission obtained from the Conservation Division or its agents before plugging was commenced? Yes

Name of Conservation Agent who supervised plugging of this well Leo F. Massey  
Producing formation Depth to top Bottom Total Depth of Well 4399 Feet  
Show depth and thickness of all water, oil and gas formations.

OIL, GAS OR WATER RECORDS

CASING RECORD

FORMATION	CONTENT	FROM	TO	SIZE	PUT IN	PULLED OUT
		0	273'	8-5/8"	274.59'	None

Describe in detail the manner in which the well was plugged, indicating where the mud fluid was placed and the method or methods used in introducing it into the hole. If cement or other plugs were used, state the character of same and depth placed, from feet to feet for each plug set.

Bottom Plug set at 600' with 70 sacks cement  
Center Plug set at 270' with 20 sacks cement  
Top Plug set at 40' with 10 sacks cement

RECEIVED  
STATE CORPORATION COMMISSION  
MAR 28 1968  
CONSERVATION DIVISION  
Wichita, Kansas

(If additional description is necessary, use BACK of this sheet)  
Name of Plugging Contractor Birmingham-Bartlett Drilling Co.  
Address 300 Kaufman Bldg., Wichita, Kansas, 67202

STATE OF KANSAS, COUNTY OF SEDGWICK  
Richard Hindery, partner of Birmingham-Bartlett Drilling Co., contractor, ss.  
being first duly sworn on oath, says: That I have knowledge of the facts, statements, and matters herein contained and the log of the above-described well as filed and that the same are true and correct. So help me God. BIRMINGHAM-BARTLETT DRILLING CO.

(Signature) By Richard Hindery  
Richard Hindery, Partner  
300 Kaufman Bldg., Wichita, Kansas, 67202  
(Address)

Subscribed and Sworn to before me this 19th day of March, 1968.



Vivian F. Yinger  
Notary Public.

MINER "F" NO. 2 WELL

LOCATION: 150' NE of SE $\frac{1}{4}$  SE $\frac{1}{4}$  Sec. 36-20S-21W Ness County, Kansas  
 OPERATOR: Pickrell Drilling Company 705 Fourth National Bank Bldg. Wichita, Kansas, 67202  
 CONTRACTOR: Birmingham-Bartlett Drilling Co. 300 Kaufman Building Wichita, Kansas, 67202  
 SURFACE CASING: 274.59' 8-5/8" OD 28# casing set at 273' with 165 sacks GL3 cement.  
 OIL STRING: None set. Dry hole. Plugged 3-14-68

SPUDED: 3-5-68  
 ROTARY DRILLING COMPLETED: 3-14-68

RECEIVED  
 STATE CORPORATION COMMISSION  
 MAR 28 1968  
 CONSERVATION DIVISION  
 Wichita, Kansas

LOG

(Figures indicate bottom of formation)

0 -	45	Post Rock
	280	Clay, Sand & Shale
	725	Shale & Shells
	737	Base Blaine Anhydrite
	835	Red Bed & Shale
	1060	Sand
	1310	Red Bed
	1387	Red Bed & Shale
	1418	Anhydrite
	2160	Shale & Shells
	3820	Lime & Shale
	3931	Lime
	4394	Lime & Shale
	4399	Lime
	4399	Rotary total depth Dry Hole

The undersigned, Richard Hindery, one of the partners of Birmingham-Bartlett Drilling Co., hereby certifies that the above is a true and correct log of the MINER "F" NO. 2 WELL, as shown in the daily drilling reports.

BIRMINGHAM-BARTLETT DRILLING CO.

By Richard Hindery  
 Richard Hindery, Partner

Subscribed and sworn to before me this 19th day of March, 1968.

Vivian F. Yinger  
 Vivian F. Yinger, Notary Public

My commission expires November 29, 1970.

