


STATE OF KANSAS
STATE CORPORATION COMMISSION

Form CP-4

WELL PLUGGING RECORD

Give All Information Completely
Make Required Affidavit
Mail or Deliver Report to:
Conservation Division
State Corporation Commission
212 No. Market
Wichita, Kansas 67202

NORTH

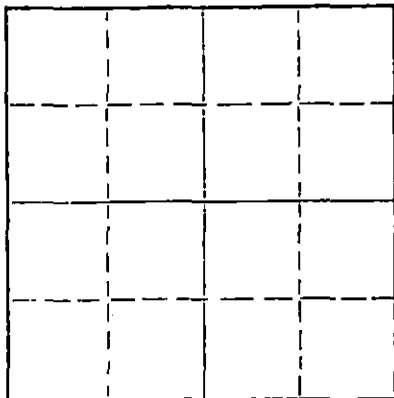

Locate well correctly on above
Section Plat

Ness County, Sec. 5 Twp. 20S Rge. (E) 23W (W)
Location as "NE/CNW*SW*" or footage from lines. C SW SE
Lease Owner Thunderbird Drilling, Inc.
Lease Name Stum "B" Well No. 1
Office Address 4328 E. Kellogg - Wichita, Kansas
Character of Well (completed as Oil, Gas or Dry Hole) dry
Date well completed 12-5 19 71
Application for plugging filed 12-5 19 71
Application for plugging approved 12-5 19 71
Plugging commenced 11:30-PM 12-5 19 71
Plugging completed 1:00 AM 12-5 19 71
Reason for abandonment of well or producing formation

If a producing well is abandoned, date of last production none 19
Was permission obtained from the Conservation Division or its agents before plugging was commenced? yes

Name of Conservation Agent who supervised plugging of this well Leo Massey
Producing formation Depth to top Bottom Total Depth of Well 4510 Feet
Show depth and thickness of all water, oil and gas formations.

OIL, GAS OR WATER RECORDS

CASING RECORD

FORMATION	CONTENT	FROM	TO	SIZE	PUT IN	PULLED OUT
Soil & shale		0	331	8 5/8"	331	0

Describe in detail the manner in which the well was plugged, indicating where the mud fluid was placed and the method or methods used in introducing it into the hole. If cement or other plugs were used, state the character of same and depth placed, from feet to feet for each plug set.

Plug hole 70 sx @ 720' - 20 sx @ 300' Bridge & Plug @ 40' w/ 10 sx
2 sx in rat hole - by Leo Massey & Globe Cementing

RECEIVED
STATE CORPORATION COMMISSION
DEC 7 1971
CONSERVATION DIVISION
Wichita, Kansas

Name of Plugging Contractor B & B Drilling, Inc. (If additional description is necessary, use BACK of this sheet)
Address 720 Union Center - Wichita, Kansas 67202

STATE OF Kansas, COUNTY OF Sedgwick, ss.
Bill Lahar (employee of owner) or (owner or operator) of the above-described well, being first duly sworn on oath, says: That I have knowledge of the facts, statements, and matters herein contained and the log of the above-described well as filed and that the same are true and correct. So help me God.

(Signature) Bill Lahar

720 Union Center - Wichita, Kansas (Address)

SUBSCRIBED AND SWORN to before me this 6th day of December, 19 71

My commission expires

May 31, 1974

Alma A. Neises
Notary Public

B & B DRILLING, INC.

~~207 Petroleum Building~~ 720 UNION CENTER
Wichita, Kansas 67202

December 6, 1971

DRILLERS LOG

Re: Stum "B" # 1
C SW SE Section 5-20S-23W
Ness County, Kansas

OPERATOR: Thunderbird Drilling, Inc.
CONTRACTOR: B & B Drilling, Inc.
COMMENCED: November 22, 1971
COMPLETED: December 5, 1971
TOTAL DEPTH: 4513' Run 8 5/8" Set @ 331' w/175 sx

0	263	Surface Hole
263	330	Surface Hole
330	1575	Shale
1575	2560	Shale & Lime
2560	2700	Shale & Lime
2700	3022	Lime
3022	3176	Lime & Shale
3176	3522	Shale
3522	3785	Shale
3785	3833	Lime
3833	4083	Lime
4083	4278	Lime
4278	4364	Lime
4364	4436	Lime
4436	4446	Lime
4446	4463	Lime
4463	4510	Lime
4510		Total Depth
4513		Loggers

RECEIVED
STATE CORPORATION COMMISSION
DEC 7 1971
CONSERVATION DIVISION
Wichita, Kansas

D & A

We certify the above and foregoing to be true and correct copy of the log on the #1 Stum "B", located in Ness County, Kansas.

Bill Laker President

Alma A. Neiser Notary public
Subscribed and sworn to before me this 6th day of December, 1971. My commission expires May 31, 1974