


WELL PLUGGING RECORD

Give All Information Completely  
Make Required Affidavit  
Mail or Deliver Report to:  
Conservation Division  
State Corporation Commission  
211 No. Broadway  
Wichita, Kansas

McPherson County. Sec. 10 Twp. 20 Rge. (E) 3 (W)

Location as "NE/CNW/SW" or footage from lines SE SW SE  
Lease Owner Natural Gas and Oil Company  
Lease Name Etter Well No. 1  
Office Address Box 105 Great Bend, Kansas  
Character of Well (completed as Oil, Gas or Dry Hole) dry hole  
Date well completed July 15 1956  
Application for plugging filed July 15 1956  
Application for plugging approved July 15 1956  
Plugging commenced July 15 1956  
Plugging completed July 15 1956  
Reason for abandonment of well or producing formation dry hole

NORTH

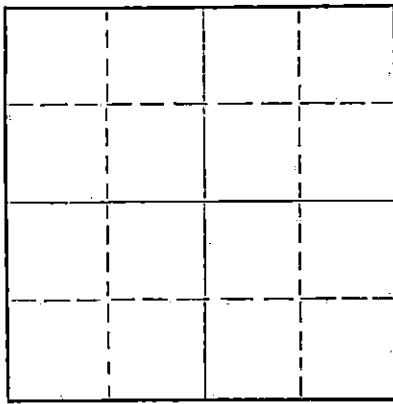

Locate well correctly on above Section Plat

If a producing well is abandoned, date of last production 19  
Was permission obtained from the Conservation Division or its agents before plugging was commenced? yes

Name of Conservation Agent who supervised plugging of this well Ruel E. Durkee  
Producing formation \_\_\_\_\_ Depth to top \_\_\_\_\_ Bottom \_\_\_\_\_ Total Depth of Well 3579 Feet  
Show depth and thickness of all water, oil and gas formations.

OIL, GAS OR WATER RECORDS

CASING RECORD

FORMATION	CONTENT	FROM	TO	SIZE	PUT IN	PULLED OUT
				8 5/8	200	none

Describe in detail the manner in which the well was plugged, indicating where the mud fluid was placed and the method or methods used in introducing it into the hole. If cement or other plugs were used, state the character of same and depth placed, from \_\_\_\_\_ feet to \_\_\_\_\_ feet for each plug set.

Hole filled with heavy rotary mud to 190 ft. Bridge at 190 ft. with wood hulls and rock with 15 sacks cement on bridge. Hole filled with heavy rotary mud to 20 ft. Bridge at 20 ft. with wood and rock and 5 sacks cement on bridge.

(If additional description is necessary, use BACK of this sheet)

Name of Plugging Contractor White & Ellis Drilling, Inc. License # 209  
Address Box 448 El Dorado, Kansas

STATE OF Kansas, COUNTY OF Butler, ss.  
Dale R. Daniel, employee of contractor (Employee of Owner or Owner's Operator) of the above-described well, being first duly sworn on oath, says: That I have knowledge of the facts, statements, and matters herein contained and the log of the above-described well as filed and that the same are true and correct. So help me God.

(Signature) Dale R. Daniel  
El Dorado, Kansas (Address)

SUBSCRIBED AND SWORN to before me this 17 th day of July, 1956

My commission expires April 18, 1959

Ernestine A. Ingram Notary Public.  
STATE CORPORATION COMMISSION

PLUGGING  
FILE SEC. 10 T. 20 R. 3W  
BOOK PAGE 81 LINE 42

JUL 12 1956  
7-19-56  
CONSERVATION DIVISION  
Wichita, Kansas

Casing Record

8 5/8" 200' cemented w/  
145 sacks

Location: SE SW SE  
Sec. 10-20S-3W  
McPherson County, Kansas  
Farm: Etter #1  
Well Owner: Natural Gas & Oil Company  
Contractor: White & Ellis Drilling, Inc.,  
Started: 7-3-56  
Completed: 7-15-56

T.D. 3579'  
Kelly bushing measurements 5' above  
ground level

Formation Depth - Figures indicate bottom of formation.

Soil	0-2	Top of Arbuckle	
Clay	30		
Sandy shale	60	Lime	3579
Sand	74 - 125		
Shale & lime shells	200	T. D.	3579
Shale	450		
Lime	510		
Lime & shale strks.	1075	Dry hole, plug and abandon	
Shale & shells	1260		
Shale	1340		
Shale & shells	1705		
Lime	1770		
Shale & lime strks.	1865		
Lime	1940		
Lime & shale	1995		
Lime	2100		
Lime & shale strks.	2208		
Douglas sand	2210		
Sandy shale	2302		
" " and lime strks.	2336		
Shale & lime	2408		
Top of Lansing			
Lime	2604		
Top of Kansas City			
Lime	2746		
Lime & shale strks.	2920		
Shale & lime strks.	3026		
Top of Mississippi			
Lime (show of oil)	3038		
Mississippi Chat	3055		
Lime	3168		
Shale	3250		
Shale & lime strks.	3390		
Top of Viola			
Lime	3412		
Lime & chat	3434		
Lime	3473		
Dolomite & sand	3489		
Sand	3504		
Shale & dolomite	3546		

**PLUGGING**  
 FILE SEC. 10 T. 20 R. 3W  
 BOOK PAGE 81 LINE 42