


Give All Information Completely
Make Required Affidavit
Mail or Deliver Return to:
Conservation Division
State Corporation Commission
211 No. Broadway
Wichita, Kansas

WELL PLUGGING RECORD

McPherson County. Sec. 8 Twp. 20 Rge. (E) 3 (W)

Location as "NE/CNW/SW" or footage from lines C NE NE NW
Lease Owner Aladdin Petroleum Corp.
Lease Name Schrag Well No. 1
Office Address 809 Petroleum Building, Wichita, Kansas
Character of Well (completed as Oil, Gas or Dry Hole) Dry Hole
Date well completed February 12, 1961
Application for plugging filed February 12, 1961
Application for plugging approved February 12, 1961
Plugging commenced February 12, 1961
Plugging completed February 12, 1961
Reason for abandonment of well or producing formation Dry Hole

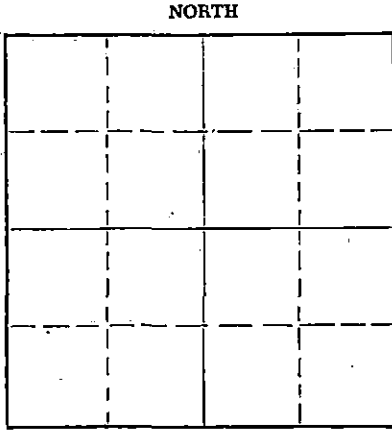

Locate well correctly on above Section Plat

If a producing well is abandoned, date of last production 19
Was permission obtained from the Conservation Division or its agents before plugging was commenced? Yes

Name of Conservation Agent who supervised plugging of this well Cecil Jones
Producing formation _____ Depth to top _____ Bottom _____ Total Depth of Well 3770 Feet
Show depth and thickness of all water, oil and gas formations.

OIL, GAS OR WATER RECORDS

CASING RECORD

FORMATION	CONTENT	FROM	TO	SIZE	PUT IN	PULLED OUT
surface	water	-0-	305'	8 5/8"	305'	none

Describe in detail the manner in which the well was plugged, indicating where the mud fluid was placed and the method or methods used in introducing it into the hole. If cement or other plugs were used, state the character of same and depth placed, from _____ feet to _____ feet for each plug set.

Heavy Mud to 240'
Howco Plug # 1 1/4 sx Hulls
20 sx cement
Heavy Mud to 35'
Howco Plug # 2 1/4 sx Hulls
8 sx cement.
Bridge rat hole - 2 sx cement

RECEIVED
STATE CORPORATION COMMISSION

FEB 20 1961 2-20-61

CONSERVATION DIVISION
Wichita, Kansas

(If additional description is necessary, use BACK of this sheet)
Name of Plugging Contractor Shawver-Armour, Inc
Address 817 Central Building, Wichita, Kansas

STATE OF KANSAS, COUNTY OF SEDGWICK, ss:
James M. Armour (employee of owner) or (owner or operator) of the above-described well, being first duly sworn on oath, says: That I have knowledge of the facts, statements, and matters herein contained and the log of the above-described well as filed and that the same are true and correct. So help me God.

(Signature) James M. Armour
James M. Armour, 817 Central Bldg.,
(Address) Wichita, Kansas

SUBSCRIBED AND SWORN TO before me this 16th day of February, 19 61

My commission expires Dec. 29th, 1963

Marjorie Hall
Marjorie Hall Notary Public.

DRILLER'S LOG

FARM NAME: Schrag # 1 LOCATION: C NE NE NW Sec. 8-20-3W
 McPherson County, Kansas
 CONTRACTOR: Shawver-Armour, Inc.
 OWNER: Aladdin Petroleum Corp. ELEVATION: 1496 K. B.
 COMMENCED: February 2, 1961 COMPLETED: February 12, 1961
 CASING RECORD: 305' 8 5/8" w/225' sx cement - 5' sx CC

FORMATION:

Anhydrite & Shale	740
Shale & Lime	980
T. Fort Riley	990
Sandy Lime & Shale	1400
Sandy Shale	1480
Shale & Lime	2494
Lime	2971
Lime & Shale	3055
Shale & Lime	3191
Mississippian Lime	3214
Lime & Chert	3350
Mississippian Lime	3390
Lime	3482
Lime & Shale	3559
Shale	3702
Shale & Lime	3726
Lime	3757
Shale & Lime	3770
ROTARY TOTAL DEPTH	3770

TOPS:

Lansing	2494
Mississippian	3176
Viola	3714
Simpson	3746

RECEIVED
 STATE CORPORATION COMMISSION

FEB 20 1961

CONSERVATION DIVISION
 Wichita, Kansas

STATE OF KANSAS)
) ss:
 SEDGWICK COUNTY)

I, James M. Armour, do hereby certify that the above log is a true and correct copy of the above captioned well as shown on the daily drilling reports.

SHAWVER-ARMOUR, INC.

BY James M. Armour
 James M. Armour

Subscribed and sworn to before me this
 16th day of February, 1961.

My commission expires Dec. 29th, 1963.

Marjorie Hall
 Marjorie Hall, Notary Public