

CARD MUST BE TYPED

State of Kansas
NOTICE OF INTENTION TO DRILL
(see rules on reverse side)

235
CARD MUST BE SIGNED

Starting Date: May 24, 1985
month day year

API Number IS- 097-21,143-0000

OPERATOR: License # 5004
Name Vincent Oil Corporation
Address 125 N. Market, Suite #1110
City/State/Zip Wichita, Ks. 67202
Contact Person Ruth Benjamin
Phone 316-262-3573

East
C. SW $\frac{1}{4}$ NW $\frac{1}{4}$... Sec 5 ... Twp 30 ... S, Rge 19W West
(location)
... 3300 ... Ft North from Southeast Corner of Section
... 4620 ... Ft West from Southeast Corner of Section
(Note: Locate well on Section Plat on reverse side)

CONTRACTOR: License # 5149
Name Wheatstate Oilfield Services, Inc.
City/State Pratt, Ks. 67124

Nearest lease or unit boundary line ... 660 ... feet.
County ... Kiowa ...
Lease Name ... Parkin "B" ... Well# 1 ...
Domestic well within 330 feet : yes no
Municipal well within one mile : yes no

Well Drilled For: Well Class: Type Equipment:
 Oil Swd Infild Mud Rotary
 Gas Inj Pool Ext. Air Rotary
 OWWO Expl Wildcat Cable

Depth to Bottom of fresh water ... 150 ... feet
Lowest usable water formation ... Kiowa Shale ...
Depth to Bottom of usable water ... 200 ... feet
Surface pipe by Alternate : 1 2
Surface pipe to be set ... 500 ... feet
Conductor pipe if any required ... n/a ... feet
Ground surface elevation ... requested ... feet MSL.
This Authorization Expires ... 11-17-85 ...
Approved By ... 5-17-85 *R.C.*

If OWWO: old well info as follows:
Operator
Well Name
Comp Date Old Total Depth
Projected Total Depth ... 5200 ... feet
Projected Formation at TD ... Mississippian ...
Expected Producing Formations

I certify that we will comply with K.S.A. 55-101, et seq., plus eventually plugging hole to K.C.C. specifications.

Date 5-15-85 Signature of Operator or Agent

Richard A. Hiebsch
Richard A. Hiebsch Title

Vice President

MHC/MONE 5-17-85
Form C-1 4/84

Must be filed with the K.C.C. five (5) days prior to commencing well
This card void if drilling not started within six (6) months of date received by K.C.C.

RECEIVED
STATE CORPORATION COMMISSION

5-17-85


MAY 17 1985

Important procedures to follow:

CONSERVATION DIVISION
Wichita, Kansas

1. Notify District office before setting surface casing.
2. Set surface casing by circulating cement to the top.
3. File completion forms ACO-1 with K.C.C. within 90 days of well completion, following instructions on ACO-1, side 1, and including copies of wireline logs.
4. Notify District office 48 hours prior to old well workover or re-entry.
5. Prior to plugging, prepare a plugging plan, then obtain agreement from the appropriate district office for an approved plugging plan.
6. Submit plugging report (CP-4) to K.C.C. after plugging is completed.
7. Obtain an approved injection docket number before disposing of salt water.
8. Notify K.C.C. within 10 days when injection commences or terminates.
9. If an alternate 2 completion, cement in the production pipe from below any usable water to surface within 120 days of spud date.

A Regular Section of Land
1 Mile = 5,280 Ft.

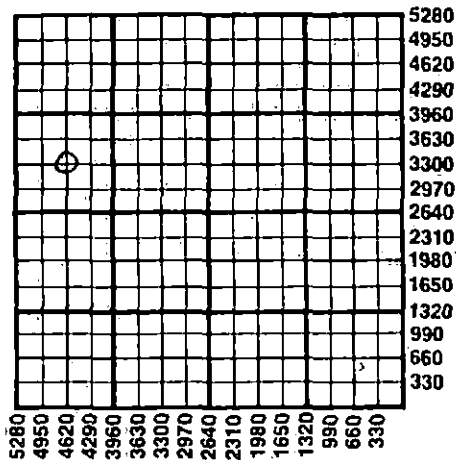

State Corporation Commission of Kansas
Conservation Division
200 Colorado Derby Building
Wichita, Kansas 67202
(316)263-3238