


STATE OF KANSAS  
STATE CORPORATION COMMISSION

Give All Information Completely  
Make Required Affidavit  
Mail or Deliver Report to:  
Conservation Division  
State Corporation Commission  
211 No. Broadway  
Wichita, Kansas

WELL PLUGGING RECORD

NORTH

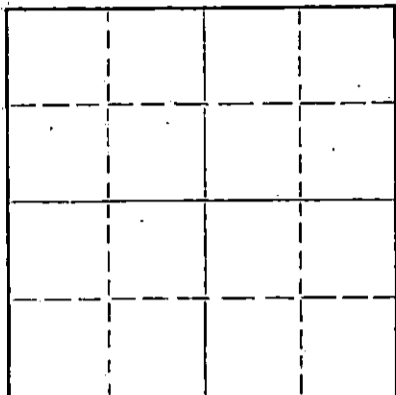

Locate well correctly on above  
Section Plat

Barton County, Sec. 34 Twp. 20 Rge. 14 (E) W. (W)  
Location as "NE/CNW/SW" or footage from lines 330' N., 280' W. of S/4 Cor.  
Lease Owner Cities Service Oil Company  
Lease Name Asher "B" Well No. 3  
Office Address Box 308, Great Bend, Kansas  
Character of Well (completed as Oil, Gas or Dry Hole) Oil Well  
Date well completed August 25, 19 55  
Application for plugging filed June 9, 19 65  
Application for plugging approved June 10, 19 65  
Plugging commenced June 23, 19 65  
Plugging completed June 23, 19 65  
Reason for abandonment of well or producing formation Depleted.

If a producing well is abandoned, date of last production August 4, 19 64  
Was permission obtained from the Conservation Division or its agents before plugging was commenced? Yes

Name of Conservation Agent who supervised plugging of this well Donald Truan  
Producing formation Lansing-Kansas City Depth to top 3288 Bottom 3461 Total Depth of Well 3542 Feet  
Show depth and thickness of all water, oil and gas formations. 3490' PBD

OIL, GAS OR WATER RECORDS

CASING RECORD

FORMATION	CONTENT	FROM	TO	SIZE	PUT IN	PULLED OUT
				8-5/8"	817'	None
				5-1/2"	3547'	2791'

Describe in detail the manner in which the well was plugged, indicating where the mud fluid was placed and the method or methods used in introducing it into the hole. If cement or other plugs were used, state the character of same and depth placed, from \_\_\_\_\_ feet to \_\_\_\_\_ feet for each plug set.

3490-3150', sand.  
3150-395', mud.  
395-350', wood plug, rock and dirt.  
350' to base of cellar, 35 sx cement.

7-2-65

RECEIVED  
STATE CORPORATION COMMISSION

JUN 2 1965

CONSERVATION DIVISION  
Wichita, Kansas

(If additional description is necessary, use BACK of this sheet)

Name of Plugging Contractor Knight Casing Pulling Co.  
Address Chase, Kansas

STATE OF Kansas, COUNTY OF Barton, ss.

H. J. Lucchi (employee of owner) of the above-described well, being first duly sworn on oath, says: That I have knowledge of the facts, statements, and matters herein contained and the log of the above-described well as filed and that the same are true and correct. So help me God.

(Signature) H. J. Lucchi  
Box 308, Great Bend, Kansas  
(Address)

SUBSCRIBED AND SWORN TO before me this 30th day of June, 19 65

My commission expires Dec. 6, 1966.

C McFarland  
Notary Public.

# WELL RECORD

15.009.02069.0006

Company Cities Service Oil Company Well No. 3 Farm Asher "B"  
 Location 330' North & 280' West of S/4 Corner Sec. 34 T. 20 R. 14W  
 Elevation 1915 (1912 Gr) County Barton State Kansas  
 Drlg. Comm. 8-13-15 Contractor Barbour Drilling Company  
 Drlg. Comp. 8-25-55 Acid 1000 gals 3404-16 Sept 1, 1955  
 T. D. 3542 PBTD 3490 Initial Prod. Physical Potential 418 oil, no water, 24 hours 10-5-55

CASING RECORD:

8-5/8" @ 817' w/150 sacks cement  
 5-1/2" @ 3541' w/125 sacks cement

FORMATION RECORD:

sand & clay	C-70
sand & gravel	205
shale	330
red bed & sand	460
red bed	605
anhydrite	840
shale & shells	1595
shale & lime	1795
lime	2090
lime & shale	2150
shale & lime	2827
lime & shale	2935
shale & lime	2960
lime & shale	3045
lime	3145
lime & shale	3290
lime	3342
lime & shale	3450
lime	3500
lime & shale	3544

3544 RTD = 3542 SLH

Corr. Heebner	3173
Corr. Brown Limestone	3278
Corr. Lansing	3291
Corr. Simpson	3518
Corr. Arbuckle	3540
Penetration	2'
T. D.	3542

Drilled cement to 3530' SLH

Perf. 13 shots 3509-12  
 " 49 " 3516-29

Bailed 2 gals oil per hour

Set L-W plug at 3491'; 1 gal rock on plug; PBTD 3490 SLH.

Perf. 46 shots 3404-16; 232' oil in 1 hr. 25 mins.

377' oil in 1 hr. 55 minutes.

Dumped 1 sack cement on plug

Slope Tests (TGTCC)

500'	0°
1000'	1°
1500'	3/4°
2000'	1°
2500'	1/4°
3130'	1/2°
3500'	3/4°

3500 0  
 1912  
 28

**RECEIVED**  
 STATE CORPORATION COMMISSION

JUN 10 1965

CONSERVATION DIVISION  
 Wichita, Kansas