

15-025-20188-0000


STATE OF KANSAS  
STATE CORPORATION COMMISSION

WELL PLUGGING RECORD

Give All Information Completely  
Make Required Affidavit  
Mail or Deliver Report to  
Conservation Division  
State Corporation Comm.  
245 North Water  
Wichita, KS 67202

Clark County, Sec. 33 Twp. 30S Rge. 23W E/W  
Location as "NE/CNW $\frac{1}{4}$ SW $\frac{1}{4}$ " or footage from lines  
NW NW

Lease Owner PICKRELL DRILLING COMPANY  
Lease Name ALLEN "D" Well No. 1  
Office Address 205 LITWIN BLDG., WICHITA, KS. 67202  
Character of Well (Completed as Oil, Gas or Dry Hole)  
Dry Hole

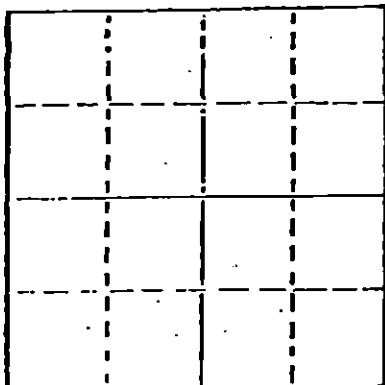

Locate well correctly on above  
Section Plot

Date Well completed 12-16-77 19  
Application for plugging filed 12-16-77 19  
Application for plugging approved 12-16-77 19  
Plugging commenced 12-16-77 19  
Plugging completed 12-16-77 19  
Reason for abandonment of well or producing formation  
Dry Hole

If a producing well is abandoned, date of last production  
19

Was permission obtained from the Conservation Division or  
its agents before plugging was commenced? Yes

Name of Conservation Agent who supervised plugging of this well Clarence Thomas, Jr.  
Producing formation Depth to top Bottom Total Depth of Well 5520

Show depth and thickness of all water, oil and gas formations.

OIL, GAS OR WATER RECORDS

CASING RECORD

FORMATION	CONTENT	FROM	TO	SIZE	PUT IN	PULLED OUT
				8 5/8"	356	None

Describe in detail the manner in which the well was plugged, indicating where the mud fluid  
was placed and the method or methods used in introducing it into the hold. If cement or other  
plugs were used, state the character of same and depth placed, from \_\_\_\_\_ feet to  
\_\_\_\_\_ feet for each plug set.

40 sacks at 350'  
12 sacks at 40'  
3 sacks in Rat Hole Comp. 12-16-77

RECEIVED  
STATE CORPORATION COMMISSION

JAN 04 1978

CONSERVATION DIVISION  
Wichita, Kansas

(If additional description is necessary, use BACK of this sheet)

Name of Plugging Contractor Pickrell Drilling Company

STATE OF Kansas COUNTY OF Clark, ss.  
C. W. Sebitts (employee of owner) or (owner or operator)  
of the above-described well, being first duly sworn on oath, says: That I have knowledge of  
the facts, statements, and matters herein contained and the log of the above-described well  
is filed and that the same are true and correct. So help me God. BY: C. W. Sebitts

(Signature)

205 LITWIN BLDG., WICHITA, KS. 67202

(Address)

SUBSCRIBED AND SWORN TO before me this 30 day of December, 19 77



Jo Ann Sarver

Notary Public.

Jo Ann Sarver

**ROTARY DRILLING LOG**

15-025-20188-0000

COMPANY: PICKRELL DRILLING COMPANY  
 205 LITWIN BLDG.  
 WICHITA, KS. 67202

LOCATION: Allen D #1  
 NW NW Sec. 33-30S-23W  
 Clark Co., Ks.

Rotary Drilling Commenced 12-03-77

Rotary Drilling Completed 12-16-77

CONTRACTOR: PICKRELL DRILLING COMPANY  
 Wichita, Kansas

CASING RECORD: Surface casing set at 356' with 175 sacks ( 8 5/8" casing)

**LOG**

(Figures indicate bottom of formation — measurements from top of rotary bushing.)

Top Soil	60	Lime	4900
Shale & Shells	360	Lime	5003
Shale	385	Lime	5080
Shale	593	Lime	5164
Shale	609	Lime	5195
Shale	1220	Shale & Lime	5225
Shale	1678	Lime & Shale	5242
Shale	1712	Lime	5316
Shale & Shells	1765	Lime	5375
Shale	2048	Lime	5390
Shale	2245	Lime	5403
Shale & Lime	2465	Lime	5457
Shale & Lime	2638	Lime	5485
Lime & Shale	2760		
Lime & Shale	2897		
Lime & Shale	3047		
Lime & Shale	3173		
Lime & Shale	3295		
Lime & Shale	3463		
Lime & Shale	3600		
Lime & Shale	3724		
Lime & Shale	3879		
Lime	3989		
Lime & Shale	4138		
Lime & Shale	4278		
Lime	4421		
Lime	4558		
Lime & Shale	4675		
Lime	4795		

Depth Correction at T.D.  
 5485=5520

RECEIVED  
 STATE CORPORATION COMMISSION  
 JAN 11 1978  
 CONSERVATION DIVISION  
 Wichita, Kansas

The undersigned, C. W. Sebitts, Attorney-in-Fact for PICKRELL DRILLING COMPANY, hereby certifies in behalf of said Company, that the above is a true and correct log of the formation encountered in drilling the above well as reflected by the Daily Drilling Reports.

PICKRELL DRILLING COMPANY  
 By [Signature]  
 Attorney-in-Fact

STATE OF KANSAS }  
 COUNTY OF SEDGWICK } ss.:

C. W. Sebitts

On this 30 day of December, 1977, before me the undersigned, a Notary Public, in and for

the County and State aforesaid, personally appeared C. W. Sebitts, to me known to be the identical person who subscribed the name of PICKRELL DRILLING COMPANY to the foregoing instrument as its Attorney-in-Fact and acknowledged to me that he executed the same as his free and voluntary act and deed, and as the free and voluntary act and deed of such company, for the uses and purposes therein set forth.

Given under my hand and seal of office the day and year last above written.

My commission expires:

[Signature]  
 Notary Public  
 Jo Ann Sarver

