

STATE OF KANSAS
STATE CORPORATION COMMISSION

WELL PLUGGING RECORD

Give All Information Completely
Make Required Affidavit
Mail or Deliver Report to
Conservation Division
State Corporation Comm.
245 North Water
Wichita, KS 67202

Barton County. Sec. 35 Twp. 20 Rge. 14
Location as "NE/CNW/SW" or footage from lines
NW NW SE


Lease Owner North American Drlg & Exploration, Inc.
Lease Name Weathers Well No. _____
Office Address 3420 10th St. Great Bend, Ks. 67530
Character of Well (Completed as Oil, Gas or Dry Hole)
Dry Hole

Date Well completed 4/16/80
Application for plugging filed 4/16/80
Application for plugging approved 4/16/80
Plugging commenced 4/16/80
Plugging completed 4/16/80
Reason for abandonment of well or producing formation
Dry Hole

If a producing well is abandoned, date of last production _____

Was permission obtained from the Conservation Division or its agents before plugging was commenced? Yes

Name of Conservation Agent who supervised plugging of this well Duane Rankin
Producing formation _____ Depth to top _____ Bottom _____ Total Depth of Well _____
Show depth and thickness of all water, oil and gas formations.

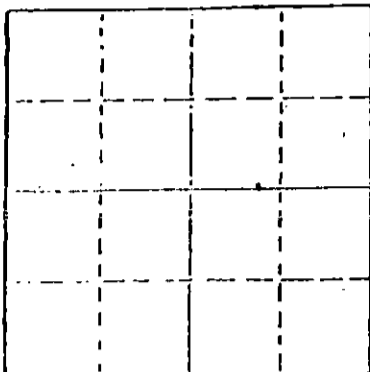

Locate well correctly on above Section Plat

OIL, GAS OR WATER RECORDS

CASING RECORDS

FORMATION	CONTENT	FROM	TO	SIZE	PUT IN	PULLED OUT
				8 5/8"	815'	

Describe in detail the manner in which the well was plugged, indicating where the mud was placed and the method or methods used in introducing it into the hold. If cement or plugs were used, state the character of same and depth placed, from _____ feet to _____ feet for each plug set.

- 4/16/80 Mud to 840', plug, plugged with 40 sx. cement.
- 4/16/80 Mud to 300', plug, plugged with 25 sx. cement.
- 4/16/80 Mud to 40', plug, plugged with 10 sx. cement
- 4/16/80 Plugged rathole with 10 sx. cement.

STATE CORPORATION COMMISSION RECEIVED

MAY 23 1980 5-23-80

CONSERVATION DIVISION
Wichita, Kansas

(If additional description is necessary, use BACK of this sheet)

Name of Plugging Contractor White & Ellis Drilling, Inc.
Box 448, El Dorado, Kansas 67042

STATE OF Kansas COUNTY OF Butler, ss.
Ernest Sifford (employee of owner) or (owner or operator)


of the above-described well, being first duly sworn on oath, says: That I have knowledge of the facts, statements, and matters herein contained and the log of the above-described well as filed and that the same are true and correct. So help me God.

(Signature) [Signature]
El Dorado (Address)

SUBSCRIBED AND SWORN TO before me this 30 day of April, 1980

[Signature] Notary Public.

My commission expires _____

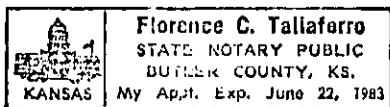

DRILLERS LOG

North American Drlg. and Exploration, Inc.
 OPERATOR: 3420 Tenth St.; Great Bend, Kansas 67530
 CONTRACTOR: **White & Ellis Drilling, Inc., Box 448, El Dorado, Kansas 67042**

Lease Name Weathers Well No. 1

Sec. 35 T. 20 R. 14W Spot NW NW SE

County Barton State Kansas Elevation _____

Casing Record:

Surface: 8 5/8" @ 815' with 425 Sxs.

Production: _____ @ _____ with _____ Sxs.

Type Well: D & A Total Depth 3590' KB

Drilling Commenced: 4/9/80 Drilling Completed 4/16/80

Formation	From	To	Tops
Cellar	0	7	Lansing & Kansas Co. 3308
Sand	7	540	
Shale, Lime	540	836	
Shale	836	1826	
Shale, Lime	1826	3044	
Lime	3044	3195	
Shale	3195	3308	
Lime	3308	3590	

COMPLETION RECORD

Liner Record: Size _____ From _____ To _____

Cementing Record: _____ Sacks _____

Perforating Record:

Formation	Perforated Interval	Number Shots
RECEIVED STATE CORPORATION COMMISSION MAY 23 1980 CONSERVATION DIVISION Wichita, Kansas		

Initial Production: _____

Electric Log _____ Type and Depths Covered _____

