


STATE OF KANSAS  
STATE CORPORATION COMMISSION

## WELL PLUGGING RECORD

Give All Information Completely  
Make Required Affidavit  
Mail or Deliver Report to:  
Conservation Division  
State Corporation Commission  
211 No. Broadway  
Wichita, Kansas

T - 20 NORTH R - 12W

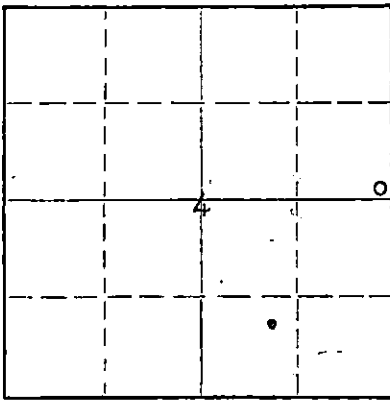

Locate well correctly on above  
Section Plat

Barton County. Sec. 4 Twp 20 Rge. 12 (E) W (W)  
Location as "NE/CNW/SW" or footage from lines. SE/SE/NE NESE  
Lease Owner Frank J. Black  
Lease Name Woodburn Well No. 1  
Office Address McPherson, Kansas  
Character of Well (completed as Oil, Gas or Dry Hole) Oil  
Date well completed 10-24-56 19  
Application for plugging filed 10-31-64 19  
Application for plugging approved 11-2-64 19  
Plugging commenced 11-9-64 19  
Plugging completed 11-18-64 19  
Reason for abandonment of well or producing formation Depleted.

If a producing well is abandoned, date of last production 19  
Was permission obtained from the Conservation Division or its agents before plugging was commenced? yes

Name of Conservation Agent who supervised plugging of this well Don Truan  
Producing formation Depth to top Bottom Total Depth of Well 3404 Feet  
Show depth and thickness of all water, oil and gas formations.

## OIL, GAS OR WATER RECORDS

## CASING RECORD

FORMATION	CONTENT	FROM	TO	SIZE	PUT IN	PULLED OUT
				8-5/8"	163'	None
				5-1/2"	3377'	2525'

Describe in detail the manner in which the well was plugged, indicating where the mud fluid was placed and the method or methods used in introducing it into the hole. If cement or other plugs were used, state the character of same and depth placed, from feet to feet for each plug set.

Checked hole to 3380', pushed plug to 3000', ran 2  
tubs of sand and dumped 5 sacks of cement with dump  
bailer. Pulled 5 1/2" casing and pumped in 15 sacks of  
gel mud and 80 sacks of cement to cap well.

RECEIVED  
STATE CORPORATION COMMISSION  
NOV 30 1964  
CONSERVATION DIVISION  
Wichita, Kansas

PLUGGING COMPLETE.

(If additional description is necessary, use BACK of this sheet)

Name of Plugging Contractor KNIGHT CASING PULLING COMPANY License #436  
Address CHASE, KANSAS

STATE OF KANSAS, COUNTY OF RICE, ss.  
Noel J. Knight (employee of owner) or (owner/operator) of the above-described

well, being first duly sworn on oath, says: That I have knowledge of the facts, statements, and matters herein contained and the log of the above-described well as filed and that the same are true and correct. So help me God.

(Signature) Noel J. Knight  
Chase, Kansas  
(Address)

SUBSCRIBED AND SWORN TO before me this 23rd day of November, 1964

My commission expires May 20, 1968

Notary Public.