

Give All Information Completely
Make Required Affidavit
Mail or Deliver Report to:
Conservation Division
State Corporation Commission
809 Bittling Building
Wichita, Kansas

WELL PLUGGING RECORD

NORTH

Locate well correctly on above
Section Plat

Barton County. Sec. 5 Twp. 20 Rge. 12 (~~EX~~) (W)
Location as "NE/CNW%SW%" or footage from lines NW NW SE
Lease Owner Hilton Drilling Company, Inc.
Lease Name Lanterman "A" Well No. 1
Office Address 2421 Tenth St., Great Bend, Kansas
Character of Well (completed as Oil, Gas or Dry Hole) Oil
Date well completed March 25, 19 54
Application for plugging filed September 19, 19 55
Application for plugging approved September 20, 19 55
Plugging commenced September 27, 19 55
Plugging completed September 29, 19 55
Reason for abandonment of well or producing formation Dry

If a producing well is abandoned, date of last production September 20, 19 55
Was permission obtained from the Conservation Division or its agents before plugging was commenced? Yes

Name of Conservation Agent who supervised plugging of this well W. H. Horner
Producing formation _____ Depth to top _____ Bottom _____ Total Depth of Well 3438 Feet
Show depth and thickness of all water, oil and gas formations.

OIL, GAS OR WATER RECORDS

CASING RECORD

FORMATION	CONTENT	FROM	TO	SIZE	PUT IN	PULLED OUT
		0	120	8-5/8"	120	None
			3437	5-1/2"	3437	2695.45

Describe in detail the manner in which the well was plugged, indicating where the mud fluid was placed and the method or methods used in introducing it into the hole. If cement or other plugs were used, state the character of same and depth placed, from _____ feet to _____ feet for each plug set.

Plugged back with sand to 3210', dump 5 sacks
cement.

Plugged surface with pump truck (Globe) pumped
ine 15 sacks gel mud, put in plug, mixed and
pumped in 85 sacks cement.
Shut in with 100# psi.

(If additional description is necessary, use BACK of this sheet)
Name of Plugging Contractor Ace Pipe Pulling Company
Address Great Bend, Kansas

STATE OF KANSAS, COUNTY OF BARTON, ss.
Henry Peacock, Secretary (employee of owner) or (owner or operator) of the above-described
well, being first duly sworn on oath, says: That I have knowledge of the facts, statements, and matters herein contained and the log of the
above-described well as filed and that the same are true and correct. So help me God.


(Signature) Henry Peacock Secretary
Great Bend, Kansas (Address)

SUBSCRIBED AND SWORN TO before me this 30th day of September, 19 55

My commission expires January 26, 1959

Carmin Reinhardt Leiler
Notary Public.

24-7368-5 3-53-20M

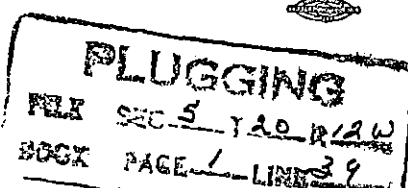

DRILLER'S LOG

Company: Hilton Drilling Company, Inc.

LOCATION: NW NW SE

Contractor: Hilton Drilling Company, Inc.

Section 5-20-12W

Barton County
Kansas

Farm Name: Lanterman No. 1

ELEVATION: 1822 KB

Commenced: 3 March 4, 1954

CASING USED: 8-5/8" @ 120'

Completed: 3 March 16, 1954

w/175 sacks.

5' 3440'

Sand	60
Sand and gravel	85
Pyrite (rough)	91
Clay	105
Hard sand	120
Sand and iron	140
Blue shale	210
Sand	255
Red Bed	390
Red Bed and shale	640
Anhydrite	666
Red Bed and shale	890
Shale and shells	1205
Shale and salt	1285
Salt, shale and lime	1480
Bro. Lime and shells	1655
Lime and shale	1800
Bro. Lime	1990
Shale and Lime shells	2050
Lime and shale	2100
Shale and lime shells	2300
Lime and shale	2460
Bro. Lime and shale	2555
Lime and shale	2675
Bro. lime and shale	2760
Lime	3007
Heebner Shale	3011
Lime and shale	3019
Heebner shale	3020
Lime - Dodge	3039
Shale and lime, Douglas	3093
Shale and lime	3163
Lime	3367
Lime - Top Arbuckle	3405
Lime	3415
Lime - Arbuckle	3440
Total Depth	3440

TOPS

Heebner	3016 - 1194
Br. Lime	3134 - 1312
Lansing	3150 - 1328
Conglomerate	3381 - 1559
Arbuckle	3395 - 1573

STATE OF KANSAS)

) ss.

COUNTY OF BARTON)

PLUGGING

 REC SEC 5 T20 R12W
 BOOK PAGE 1 LINE 29

I, the undersigned, being duly sworn on oath, state that the above statement and log are true and a correct record and log of the well drilled at the location above described.


HILTON DRILLING COMPANY, INC.


 Henry Peacock, Secretary

Subscribed and sworn to before me this 24 day of March, 1954.

My commission expires

4-4-56

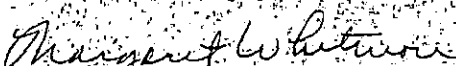
 Margaret Whitman
 Notary Public