

WELL PLUGGING RECORD


Give All Information Completely
Make Required Affidavit
Mail or Deliver Report to:
Conservation Division
State Corporation Commission
800 Basing Building
Wichita, Kansas

BARTON

County. Sec. 5 Twp. 20 Rge. (E) 12 (W)

Location as "NE/CNW $\frac{1}{4}$ /SW $\frac{1}{4}$ " or footage from lines SE SE NE
Lease Owner E. H. Adair
Lease Name Lanterman Well No. 1
Office Address 407 W-K-H Building
Character of Well (completed as Oil, Gas or Dry Hole) Dry Hole
Date well completed February 29 1952
Application for plugging filed February 29 1952
Application for plugging approved February 29 1952
Plugging commenced February 29 1952
Plugging completed February 29 1952
Reason for abandonment of well or producing formation Barren

NORTH

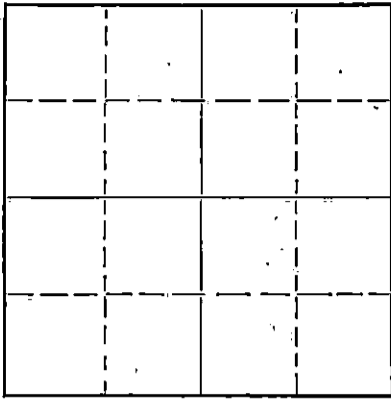

Locate well correctly on above
Section Flat

If a producing well is abandoned, date of last production 19
Was permission obtained from the Conservation Division or its agents before plugging was commenced? Yes

Name of Conservation Agent who supervised plugging of this well C. D. Stough
Producing formation Depth to top Bottom Total Depth of Well 3408 Feet
Show depth and thickness of all water, oil and gas formations.

OIL, GAS OR WATER RECORDS

CASING RECORD

Formation	Content	From	To	Size	Put In	Pulled Out
Copy of well log attached						

Describe in detail the manner in which the well was plugged, indicating where the mud fluid was placed and the method or methods used in introducing it into the hole. If cement or other plugs were used, state the character of same and depth placed, from feet to feet for each plug set.

Placed wooden plug 2t 178', put 15 sx cement on plug, filled hole with mud up to 35', placed wooden plug, 10 sx cement on plug, filled hole up to surface.

(If additional description is necessary, use BACK of this sheet)

Name of Plugging Contractor E. H. Adair Oil Co. 3-13-1952
Address Wichita 2, Kansas

STATE OF Kansas COUNTY OF Sedgwick ss.
Russell I. Baker (employee of owner) or (owner or operator) of the above-described well,

being first duly sworn on oath, says: That I have knowledge of the facts, statements and matters herein contained and the log of the above-described well as filed and that the same are true and correct. So help me God.


(Signature) Russell I. Baker

Wichita, Kansas
(Address)

SUBSCRIBED AND SWORN to before me this 11th day of March, 1952

My commission expires September 15, 1953

Notary Public.

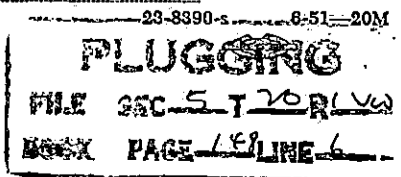

15-069-00164-0000

E. H. ADAIR OIL COMPANY

Sec. 5 T. 20 R 12W

Lanterman #1

SE SE NE

Comm. 2/19/52 Comp. 2/29/52

Barton County, Kansas

Total Depth 3408'

178" 8 5/8" s/csg, 150 sx cement

1817' DF

Soil, sand	0-60
Shale	60-130
Lime	130-138
Shale (blue)	138-178
Shale	178-270
Shale & Sand	270-640
Anhydrite	640-665
Shale	665-1515
Lime	1515-2150
Shale & shells	2150-2518
Shale & Lime	2518-2610
Shale & Shells	2610-2760
Lime	2760-3004
Shale & Shells	3004-3020
Lime & Shale	3020-3120
Shale	3120-3132
Lime	3132-3408

Total Depth Rotary

CERTIFIED CORRECT

R. Baker

MAR 18 1952
CC: ... DIVISION
... KANSAS

PLUGGING
FILE SEC 5 T 20 R 12 W
BOOK PAGE 108 LINE 6