


STATE OF KANSAS
STATE CORPORATION COMMISSION

WELL PLUGGING RECORD

All Information Completely
Required Affidavit
or Deliver Report to:
Conservation Division
State Corporation Commission
211 No. Broadway
Wichita, Kansas

Barton County. Sec. 14 Twp. 20S Rge. 12W (X) (W)
Location as "NE/CNW/SW" or footage from lines NW NE SE
Lease Owner Herman George Kaiser, Oil Producer
Lease Name Krueger Well No. 5
Office Address 909 Palace Bldg, Tulsa, Oklahoma
Character of Well (completed as Oil, Gas or Dry Hole) Dry Hole
Date well completed 1-15-64 19
Application for plugging filed 1-15-64 19
Application for plugging approved 1-15-64 19
Plugging commenced 1-15-64 19
Plugging completed 1-15-64 19
Reason for abandonment of well or producing formation Dry Hole

NORTH

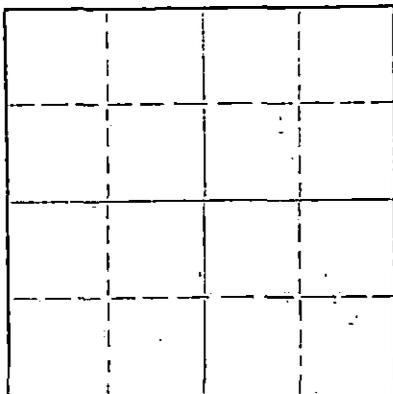

Locate well correctly on above
Section Plat

If a producing well is abandoned, date of last production _____ 19____
Was permission obtained from the Conservation Division or its agents before plugging was com-
menced? yes

Name of Conservation Agent who supervised plugging of this well Archie Elving, Pratt, Kansas
Producing formation _____ Depth to top _____ Bottom _____ Total Depth of Well 3375 Feet

Show depth and thickness of all water, oil and gas formations.

OIL, GAS OR WATER RECORDS

CASING RECORD

FORMATION	CONTENT	FROM	TO	SIZE	PUT IN	PULLED OUT
				8 5/8"	250.14	none

Describe in detail the manner in which the well was plugged, indicating where the mud fluid was placed and the method or methods used in introducing it into the hole. If cement or other plugs were used, state the character of same and depth placed, from _____ feet to _____ feet for each plug set.


Mud
Bottom plug @ 265' with 25 sks. cement
Mud
Top plug @ 40' with 10 sks. cement
2 sks. in rathole.

(If additional description is necessary, use BACK of this sheet)

Name of Plugging Contractor Leben Drilling, Inc.
Address Box 486, Great Bend, Kansas

STATE OF KANSAS, COUNTY OF BARTON, ss.

Leslie Kite (employee of owner) or (owner or operator) of the above-described well, being first duly sworn on oath, says: That I have knowledge of the facts, statements, and matters herein contained and the log of the above-described well as filed and that the same are true and correct. So help me God.

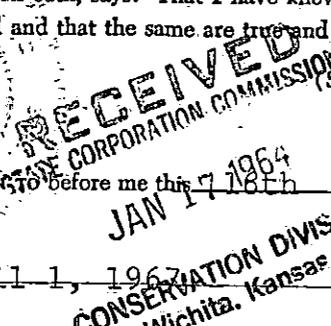

(Signature) Leslie Kite
Box 486, Great Bend, Kansas
(Address)

SUBSCRIBED AND SWORN to before me this 7 day of January, 1964

My commission expires April 1, 1967
Ulanda Nichols Notary Public.

1-17-1964

DRILLER'S LOG

COMPANY: Herman George Kaiser
 Oil Producer
 CONTRACTOR: LEBEN DRILLING, INC.
 FARM: KRUEGER #5
 LOCATION: NW NE SE Sec. 14-20S-12W.
 BARTON COUNTY, KANSAS
 COMMENCED: 1-8-64
 COMPLETED: 1-15-64

0	115	Sand
115	120	Pyrite
120	180	Shale & Sand
180	251	Shale
251	615	Redbed
615	645	Anhydrite
645	1270	Redbed & Shale
1270	1630	Shale & Lime
1630	1905	Lime
1905	1980	Lime & Shale
1980	2590	Shale & Lime
2590	2890	Lime & Shale
2890	2958	Lime
2958	3106	Lime & Shale
3106	3342	Lansing Lime
3342	3348	Lime & Chert
3348	3362	Arbuckle
3362	3375	Lime
	<u>3375</u>	<u>Rotary Total Depth</u> - D. & A.

Set 8" 5/8" used surface casing @ 250.14' with landing joint cemented with 250 sacks Sunset. Found cement @ 40' cemented with 40 sacks cement at 15'.

I, Leslie Kite, do hereby certify that the above and foregoing is a true and correct copy of the log of the Krueger #5 well, located NW NE SE of Section 14, Township 20 South, Range 12 West, Barton County, Kansas, as reflected by the files of Leben Drilling, Inc.

Leslie Kite

Leslie Kite

STATE OF KANSAS)
) SS
 COUNTY OF BARTON)

Subscribed and sworn to before me, a Notary Public, in and for Barton County, Kansas, this 16th day of January, 1964.

Ulanda Nichols

Ulanda Nichols, Notary Public

My Commission Expires
 April 1, 1967

RECEIVED
 STATE CORPORATION COMMISSION

JAN 17 1964

CONSERVATION DIVISION
 Wichita, Kansas