


WELL PLUGGING RECORD

Give All Information Completely
Make Required Affidavit
Mail or Deliver Report to:
Conservation Division
State Corporation Commission
211 No. Broadway
Wichita, Kansas

NORTH

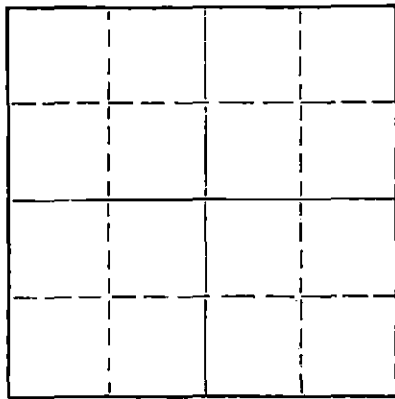

Locate well correctly on above
Section Plat

Barton County, Sec. 14, Twp. 20S Rge. 12W (E) (W)
Location as "NE/CNW/SW" or footage from lines N 1/2 SE NE
Lease Owner Herman Geo. Kaiser, Oil Producer
Lease Name Buckbee Well No. 3
Office Address 909 Palace Bldg., Tulsa, Okla. 74103
Character of Well (completed as Oil, Gas or Dry Hole) Dry Hole
Date well completed 11-22-65 19
Application for plugging filed 11-22-65 19
Application for plugging approved 11-22-65 19
Plugging commenced 11-22-65 19
Plugging completed 11-22-65 19
Reason for abandonment of well or producing formation Dry Hole

If a producing well is abandoned, date of last production _____ 19____
Was permission obtained from the Conservation Division or its agents before plugging was commenced? yes

Name of Conservation Agent who supervised plugging of this well Gilbert Leiker, Victoria, Kansas
Producing formation _____ Depth to top _____ Bottom _____ Total Depth of Well 3366 Feet
Show depth and thickness of all water, oil and gas formations.

OIL, GAS OR WATER RECORDS

CASING RECORD

FORMATION	CONTENT	FROM	TO	SIZE	PUT IN	PULLED OUT
				8 5/8"	258'	none

Describe in detail the manner in which the well was plugged, indicating where the mud fluid was placed and the method or methods used in introducing it into the hole. If cement or other plugs were used, state the character of same and depth placed, from _____ feet to _____ feet for each plug set.

Mud to 250', 1/2 sk. hulls, plug, 25 sks. cement through drill pipe
Mud to 40', 1/2 sk. hulls, plug, 10 sks. cement
2 sks. cement in rathole

STATE CORPORATION COMMISSION

NOV 29 1965

CONSERVATION DIVISION
WICHITA, KANSAS

(If additional description is necessary, use BACK of this sheet)

Name of Plugging Contractor Leben Drilling, Inc.
Address Box 486, Great Bend, Kansas

STATE OF KANSAS, COUNTY OF BARTON, ss.
Leslie Kite

(employee of owner) or (owner or operator) of the above-described well, being first duly sworn on oath, says: That I have knowledge of the facts, statements, and matters herein contained and the log of the above-described well as filed and that the same are true and correct. So help me God.

(Signature) Leslie Kite

P. O. Box 486, Great Bend, Kansas
(Address)

SUBSCRIBED AND SWORN TO before me this 23rd day of November, 19 65

My commission expires April 1, 1967

Ulanda Nichols
Notary Public.

DRILLER'S LOG

COMPANY: Herman Geo. Kaiser, Oil Producer
 CONTRACTOR: LEBEN DRILLING, INC.
 FARM: BUCKBEE #3
 LOCATION: N½ SE NE Sec. 14-20S-12W
 BARTON COUNTY, KANSAS
 COMMENCED: 11-17-65
 COMPLETED: 11-22-65

0	70	Sand
70	90	Blue Shale
90	235	Shale, Sand
235	258	Redbed
258	583	Shale, Shells
583	590	Anhydrite
590	1410	Shale, Shells
1410	1612	Lime, Shale
1612	1780	Shale, Lime
1780	1950	Lime, Shale
1950	2187	Shale
2187	2800	Shale, Lime
2800	2945	Lime
2945	3096	Lime, Shale
3096	3366	Lime
	<u>3366</u>	<u>RTD - D. & A.</u>

RECEIVED
 STATE CONSERVATION COMMISSION
 NOV 29 1965
 CONSERVATION DIVISION
 WICHITA, KANSAS

Set 8 5/8" used surface casing @ 258' with 275 sacks Sunset

I, Leslie Kite, do hereby certify that the above and foregoing is a true and correct copy of the log of the Buckbee #3 well, located N½ SE NE of Section 14, Township 20 South, Range 12 West, Barton County, Kansas, as reflected by the records of Leben Drilling, Inc.

Leslie Kite

 Leslie Kite

STATE OF KANSAS)
) SS
 COUNTY OF BARTON)

Subscribed and sworn to before me, a Notary Public, in and for Barton County, Kansas, this 23rd day of November, 1965.

Ulanda Nichols

 Ulanda Nichols

My Commission Expires:
 April 1, 1967