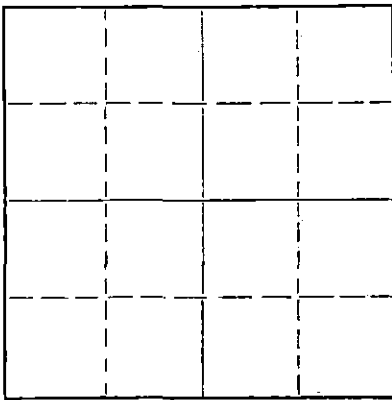


WELL PLUGGING RECORD

Give All Information Completely
Make Required Affidavit
Mail or Deliver Report to:
Conservation Division
State Corporation Commission
211 No. Broadway
Wichita, Kansas

NORTH

Locate well correctly on above
Section Plat

Barton

County. Sec. 14 Twp. 20S Rge. 12W (E) (W)

Location as "NE/CNW/SW" or footage from lines SW NW SW
Lease Owner The Texas Company
Lease Name Lizzie Buckbee "C" Well No. 1
Office Address 614 Bitting Building, Wichita, Kansas
Character of Well (completed as Oil, Gas or Dry Hole) Dry - converted to SWD
Date well completed March 22 19 54
Application for plugging filed March 7 19 56
Application for plugging approved March 8 19 56
Plugging commenced March 17 19 56
Plugging completed March 17 19 56
Reason for abandonment of well or producing formation

If a producing well is abandoned, date of last production 19

Was permission obtained from the Conservation Division or its agents before plugging was commenced? Yes

Name of Conservation Agent who supervised plugging of this well Mr. R. M. Brundage

Producing formation Depth to top Bottom Total Depth of Well 3485 Feet

Show depth and thickness of all water, oil and gas formations. PBD 3225

OIL, GAS OR WATER RECORDS

CASING RECORD

FORMATION	CONTENT	FROM	TO	SIZE	PUT IN	PULLED OUT
				10-3/4"	625'	0'
				7"	3401'	2738'

Describe in detail the manner in which the well was plugged, indicating where the mud fluid was placed and the method or methods used in introducing it into the hole. If cement or other plugs were used, state the character of same and depth placed, from feet to feet for each plug set.

PLUGGED AS FOLLOWS:

3225' to 210' - Heavy Mud
210' to 200' - Rock Bridge
200' to 150' - 25 Sacks Cement
150' to 30' - Heavy Mud
30' to Bottom of Cellar - 15 Sacks Cement

(If additional description is necessary, use BACK of this sheet)

Name of Plugging Contractor R & S Pipe Pulling Company
Address Box 192, Ellinwood, Kansas

STATE OF Kansas COUNTY OF Sedgwick ss.
Herbert L. Murray (employee of owner) or (owner or operator) of the above-described

well, being first duly sworn on oath, says: That I have knowledge of the facts, statements, and matters herein contained and the log of the above-described well as filed and that the same are true and correct. So help me God.

(Signature) Herbert L. Murray
614 Bitting Building, Wichita, Kansas
(Address)

SUBSCRIBED AND SWORN to before me this 19th day of March 19 56


My commission expires September 20, 1956

STATE CORPORATION COMMISSION Notary Public.

MAR 21 1956

CONSERVATION DIVISION
Wichita, Kansas

3-21-1956

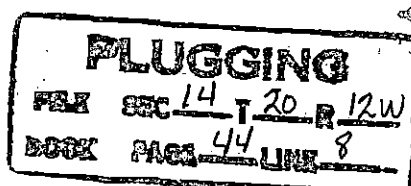

LOG OF WELL

FORM PO-214, Sheet 1 (11-53) 25M

LIZZIE BUCKBEE "C" NO. 1

SHEET 1

OWNER The Texas Company DIVISION Oklahoma DATE MADE April 23, 1954
DISTRICT Kansas LEASE Lizzie Buckbee "C" WELL NO. 1
STATE Kansas COUNTY OR PARISH Barton TWP. 20S RANGE 12W SEC. 11
LOCATION OF WELL SW NW SW

COMMENCED RIGGING UP 2-27-54 COMMENCED DRILLING 2-28-54 COMPLETED DRILLING 3-22-54
DAY DRILLER NIGHT DRILLER CONTRACTOR
CABLE FROM 3382' TO 3485' ROTARY FROM 0' TO 3382' COMPANY RIG NO.
TOTAL DEPTH 3485' MEASURED BY M. C. Harrell ELEVATION KB - 1817'
GF - 1814'
GL - 1812'

PEID 3225'

CASING RECORD

SIZE	WEIGHT	PUT IN WELL		PULLED OUT		LOST IN WELL		SHOES		PACKERS	
		FEET	INS.	FEET	INS.	FEET	INS.	LENGTH	MAKE	KIND	LENGTH
10-3/4"	32.75#	625'				(R-2, H-4C, new casing)					FT.
7"	20#	3401'				(R-2, J-55, new and old casing)					FT.
											FT.
											FT.
											FT.
											FT.
10-3/4" casing set at 611' with 350 sacks cement, 4 sacks CC. Cement circulated.											
7" casing set at 3381' with 100 sacks cement, 3% gel.											

WAS CASING CEMENTED? IF SO, HOW MANY SACKS OF CEMENT USED?
LINER: STATE SIZE AND WEIGHT WHERE SET FT. AND INS. BLANK FT. AND INS. PERFORATED
HOW PUT TOGETHER COUPLING FLUSH JOINT INSERTED
REMARKS:

EQUIPMENT RECORD

TUBING				SUCKER RODS				PUMPING OUTFIT			
SIZE	WEIGHT	FEET	INS.	FEET	INS.	SIZE AND KIND		DESCRIPTION, KIND, SIZE, ETC.			

FLOWING, PUMPING, GASSER OR DRY Dry PRODUCTION FIRST 24 HOURS PRODUCTION SETTLED
IF GAS WELL, OPEN FLOW CAPACITY SHUT IN PRESSURE ROCK PRESSURE
KIND OF SHOT SIZE OF SHOT, QUARTS
NUMBER OF SHELLS SIZE OF SHELLS INCHES, DIAMETER
LENGTH OF SHELLS FEET INCHES TOP OF SHOT
BOTTOM OF SHOT ANCHOR WELL BRIDGED TO
TOTAL DEPTH OF WELL NUMBER OF SHOT PRODUCTION BEFORE SHOT BBLS. PER DAY
PRODUCTION AFTER SHOT BBLS. PER DAY SHOT FURNISHED BY
NAME OF SHOOTER SHOT INSPECTED BY (COMPANY EMPLOYEE)
COMMENCED DRILLING DEEPER COMPLETED DRILLING DEEPER
TOTAL DEPTH PRODUCTION FIRST 24 HOURS PRODUCTION SETTLED

REMARKS: Lizzie Buckbee "C" #1
Buckbee SW
TD 3485' - PEID 3225'
Completed drilling 3-22-54

NOTE: IF WELL WAS DRY, STATE UNDER REMARKS, WHEN, HOW, AND BY WHOM PLUGGED.
STATE UNDER REMARKS ANYTHING OF INTEREST NOT COVERED IN LOG.
IF THE SPACE PROVIDED FOR REMARKS IS NOT SUFFICIENT WRITE ON BOTTOM OF LAST SHEET OF LOG.

PLUGGING

FILE SEC 14 T 20 R 12W
BOOK PAGE 44 LINE 8

TOTAL NUMBER OF SHEETS

LOG OF WELL

SHEET No. 2

District Kansas

Owner The Texas Company Farm Lizzie Buckbee "C" Well No. 1

FORMATION	AMOUNT	COLOR	HARD OR SOFT	DEPTH CORES TAKEN	REMARKS
REMARKS:					
3-14-54					Moved in cable tools and drilled out cement and cleaned out to bottom, no show of oil.
3-15-54					Drilled to 3427' in Arbuckle. Tested 1 quart oil per hour, no water.
3-16-54					Ran tubing with pilot and acidized open hole with 500 gallons acid, maximum pressure 1800#, with 50% pressure drop in 5 minutes.
3-17-54					Swabbed to bottom, tested 16 gallons oil and 185 gallons water in 11 hours.
3-19-54					Drilled to 3482' in Arbuckle, bailed 13 barrels water in 2 hours.
3-20-54					Drilled to 3484' in Arbuckle, tested 10 gallons oil and 4 barrels water per hour for 3 hours. Set bridge plug at 3350' and plugged back to 3346' with 1 sack calseal. Perforated 3292-98' with 16 jets, no show. Acidized with 1000 gallons 15%, maximum pressure 1100#, broke to 750#, with 125% pressure drop in 5 minutes. Swabbed to bottom, tested 3/4 gallons load oil and 55 gallons water per hour for 5 hours.
3-21-54					Drove bridge plug at 3350' to bottom, tools stuck for 3 hours. Set bridge plug at 3275'. Perforated 3236-42' with 54 shots, no show. Acidized with 1000 gallons 15%, maximum pressure 800#, minimum 675#, with 150% pressure drop in 5 minutes. Swabbed to bottom, tested 8 barrels water per hour, no oil for 4 hours.
3-22-54					Set bridge plug at 3230' and plugged back to 3225' with 1 sack calseal. Perforated 3212-16' with 12 shots, tested 2 gallons water per hour, no show oil. Acidized with 500 gallons 15% acid, maximum pressure 700#, no break, with 175% pressure drop in 5 minutes. Swabbed to bottom, tested 5-1/2 barrels water per hour, no oil for 5 hours.
3-23-54					Tested 5-1/2 barrels water, no oil for 3 hours. Well dry.

CASING RECORD:Measurement from
BH-KB 7.7', BH-GL 2.7'

Top of cement 2808'

Centralizers:

3180', 3280', 3380'.

TOPS:

Topeka-----2736
 Brown Lansing-----3125
 Lansing-----3143
 Conglomerate-----3373
 Arbuckle-----3378

PLUGGING

FILE SEC 14 T 20 R 12 W
 BOOK PAGE 44 LINE 8

D R I L L E R ' S L O G

The Texas Company
 #1 Lizzie Buckbee "C"
 SW NW SW 14-20S-12W
 Barton County, Kansas

<u>TO</u>	<u>FROM</u>	
0	150	Sand
150	290	Shale & Shell
290	601	Red Bed
601	634	Anhydrite
634	1410	Shale & Shells
1410	1445	Shale & Lime
1445	1635	Lime
1635	1742	Lime & Shale
1742	1890	Shale & Lime
1890	2470	Lime & Shale
2470	2585	Shale & Lime
2585	2695	Lime & Shale
2695	2806	Shale & Lime
2806	2914	Lime
2914	2981	Shale & Lime
2981	3071	Lime & Shale
3071	3125	Shale
3125	3146	Lime
3146	3207	Shale & Lime
3207	3354	Lime
3354	3379	Lime & Shale
3379	3382	Arbuckle
	3382	ROTARY TOTAL DEPTH

COMMENCED: 2-27-54
 COMPLETED: 3-10-54

CASING RECORD:

Set 10-3/4" surface casing at
 611' with 350 sacks cement.

STATE OF KANSAS)
) SS
 COUNTY OF SEDGWICK)

I hereby affirm that the above and foregoing is a true and correct
 copy of the log of the #1 Lizzie Buckbee "C" located SW NW SW of Section
 14-20S-12W, Barton County, Kansas.

ANSCHUTZ DRILLING CO., INC.

BY E. G. Koelling
 E. G. Koelling

Subscribed and sworn to before this 12th of March, 1954.

Helen L. Long
 Notary Public

My Commission Expires: November 21, 1956.

