


Give All Information Completely
Make Required Affidavit
Mail or Deliver Report to:
Conservation Division
State Corporation Commission
212 North Market, Insurance Bldg.
Wichita, Kansas

WELL PLUGGING RECORD

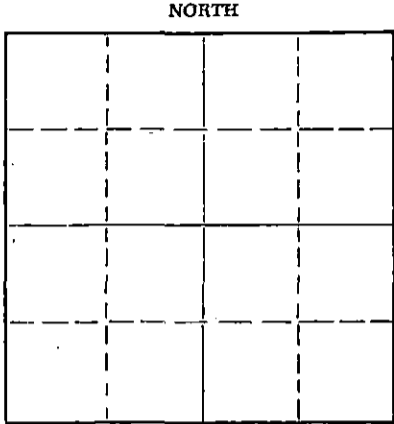

Locate well correctly on above
Section Plat

Barton County. Sec. 14 Twp. 20S Rge. 12W (E) (W)
Location as "NE/CNW/SW" or footage from lines SE SE NW
Lease Owner ALPINE OIL & ROYALTY CO., INC.
Lease Name BUCKBEE Well No. 4
Office Address 800 Bitting Building, Wichita, Kansas
Character of Well (completed as Oil, Gas or Dry Hole) dry hole
Date well completed December 22, 1958 19
Application for plugging filed December 22, 1958 19
Application for plugging approved December 22, 1958 19
Plugging commenced December 22, 1958 19
Plugging completed December 22, 1958 19
Reason for abandonment of well or producing formation non-productive in
commercial quantities
If a producing well is abandoned, date of last production _____ 19
Was permission obtained from the Conservation Division or its agents before plugging was com-
menced? Yes

Name of Conservation Agent who supervised plugging of this well Frank Broadfoot
Producing formation _____ Depth to top _____ Bottom _____ Total Depth of Well 3400 Feet
Show depth and thickness of all water, oil and gas formations.

OIL, GAS OR WATER RECORDS

CASING RECORD

FORMATION	CONTENT	FROM	TO	SIZE	PUT IN	PULLED OUT
				8 5/8	200'	cemented

Describe in detail the manner in which the well was plugged, indicating where the mud fluid was placed and the method or methods used in introducing it into the hole. If cement or other plugs were used, state the character of same and depth placed, from _____ feet to _____ feet for each plug set.

Heavy mud from Total Depth - 3400 feet to 180 feet
Solid plug at 180 feet and 20 sacks cement on top
mud to 35 feet - another plug and 10 sacks cement

(If additional description is necessary, use BACK of this sheet)

Name of Plugging Contractor Chief Drilling Co., Inc.
Address Box 96, Great Bend, Kansas

STATE OF Kansas, COUNTY OF Sedgwick; ss.
Thomas M. McCaul (employee of owner) or (owner or operator) of the above-described well, being first duly sworn on oath, says: That I have knowledge of the facts, statements, and matters herein contained and the log of the above-described well as filed and that the same are true and correct. So help me God.

(Signature) Thomas M. McCaul
800 Bitting Building, Wichita, Kansas
(Address)

SUBSCRIBED AND SWORN to before me this 2nd day of January, 19 59

My commission expires August 10, 1961

RECEIVED
STATE CORPORATION COMMISSION
Notary Public.

JAN 3 1959

PLUGGING
FILE SEC 14 T 20 R 12 W
BOOK PAGE 5 LINE 38
CONSERVATION DIVISION
Wichita, Kansas

W E L L L O G

No. 4 Lizzie Buckbee

Alpine Oil & Royalty Co., Inc.
1100 Bitting Building
Wichita, Kansas

Commenced: December 15, 1958
Completed: December 22, 1958

Elevation: 1803' DF
1806' KB

No. 4 Lizzie Buckbee
SE SE NW Sec. 14-20S-12W
Barton County, Kansas

Contractor: Chief Drilling Co., Inc.

Rotary: 0-3400' T.D.

DRY AND ABANDONED

Casing Record: 8-5/8" surface casing set @200' with 200 sacks HA-5 Cement. Cement circulated.

Formation

Sand	0	75
Shale	75	200
Sand and Shale	200	210
Sand	210	225
Red Bed, Shale and Sand	225	590
Anhydrite	590	605
Shale and Shells	605	1390
Shale and Lime	1390	1430
Lime	1430	1560
Lime and Shale	1560	2835
Lime	2835	3400

STATE OF KANSAS)
) SS,
COUNTY OF BARTON)

I hereby certify that the above is a true and correct copy of Driller's Log of well drilled in the SE SE NW of Section 14, Township 20 South, Range 12 West, Barton County, Kansas, to the best of my knowledge and belief.

CHIEF DRILLING CO., INC.

Richard Hoover
V. Richard Hoover, President

Subscribed to and sworn to before me this 23rd day of December, 1958.

RECEIVED
STATE CORPORATION COMMISSION
JAN 5 1959
CONSERVATION DIVISION
Wichita, Kansas

Maryl Johnson
Mary O. Johnson, Notary Public

My Commission Expires:
November 21, 1959

PLUGGING
FILE SEC. 14 T. 20 R. 12W
BOOK PAGE 5 LINE 38