


WELL PLUGGING RECORD

Give All Information Completely
Make Required Affidavit
Mail or Deliver Report to:
Conservation Division
State Corporation Commission
800 Bitting Building
Wichita, Kansas

Barton County, Sec. 14 Twp. 20 Rge. (E) 12 (W)

Location as "NE/CNW/SW" or footage from lines SE NE SW
Lease Owner Rocket Drilling Company, Inc.
Lease Name Buckbee Well No. 1
Office Address 352 North Broadway, Wichita 2, Kansas
Character of Well (completed as Oil, Gas or Dry Hole) Dry Hole
Date well completed March 23, 1955 19 55
Application for plugging filed March 24, 19 19 55
Application for plugging approved March 25 19 55
Plugging commenced March 23 19 55
Plugging completed March 23 19 55
Reason for abandonment of well or producing formation Dry Hole

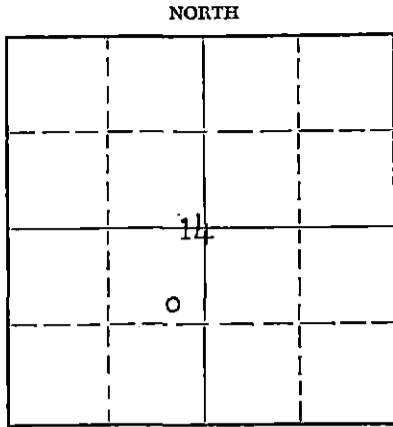

Locate well correctly on above Section Plat

If a producing well is abandoned, date of last production 19
Was permission obtained from the Conservation Division or its agents before plugging was commenced? Yes

Name of Conservation Agent who supervised plugging of this well Warren H. Horner, Box 207, Great Bend, Ks.

Producing formation -- Depth to top Bottom Total Depth of Well 3418 Feet
Show depth and thickness of all water, oil and gas formations.

OIL, GAS OR WATER RECORDS

CASING RECORD

FORMATION	CONTENT	FROM	TO	SIZE	PUT IN	PULLED OUT
				8-5/8"	256'	None

Describe in detail the manner in which the well was plugged, indicating where the mud fluid was placed and the method or methods used in introducing it into the hole. If cement or other plugs were used, state the character of same and depth placed, from feet to feet for each plug set.

Filled hole with mud to 250'. Set plug and cemented with 20 sacks cement, 1 sack hulls. Filled hole with mud to 35'. Set plug and cemented with 10 sacks cement, 1/3 sack hulls.

(If additional description is necessary, use BACK of this sheet)

Name of Plugging Contractor Rocket Drilling Company, Inc.
Address 352 North Broadway Wichita 2, Kansas

STATE OF KANSAS, COUNTY OF SEDGWICK, ss. B. W. Burks (employee of owner)

well, being first duly sworn on oath, says: That I have knowledge of the facts, statements, and matters herein contained and the log of the above-described well as filed and that the same are true and correct. So help me God.

(Signature) [Signature] 352 North Broadway, Wichita 2, Kansas (Address)


SUBSCRIBED AND SWORN TO before me this 29th day of March, 1955

[Signature] Notary Public.

My commission expires March 5, 1958

PLUGGING
FILE DEC 14 T 290 12W
BOOK PAGE 107 LINE 6

3-30-1955

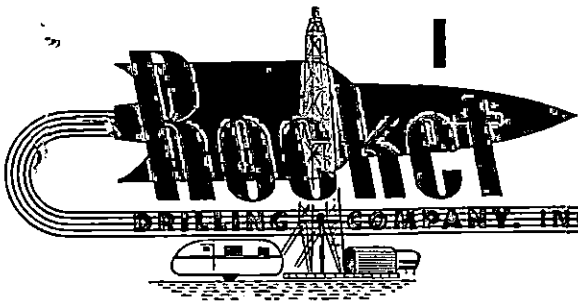

15.009.00558.0000

Rocket Drilling Company, Inc.
 #1 Buckbee
 SE NE SW Section 14-20-12W
 Barton County, Kansas

Elevation: 1807 R.B.
 Spudded: March 16, 1955
 Rotary Completed: March 23, 1955
 Results: Dry and Abandoned
 Contractor: Rocket Drilling Company, Inc.

CASING RECORD

256' of 8-5/8" O.D. 24# Seamless Casing cemented with 200 sacks cement.

DRILLERS LOG

Sand	0 to 125	Lime	1780
Sand & Iron	130	Sand	1790
Blue Shale & Shells	200	Lime	1930
Sand	215	Sand	1935
Red Shale	256	Lime	2130
Shale & Shells	600	Shale & Lime	2215
Anhydrite	630	Shale	2440
Shale & Salt	1190	Shale & Lime	3149
Shale & Lime	1715	Lime	3380
Lime	1730	Arbuckle	3418 TD
Sand	1740		

STATE OF KANSAS)
) SS:
 COUNTY OF SEDGWICK)

I hereby certify that to the best of my knowledge and belief, the foregoing log is true and correct.

ROCKET DRILLING COMPANY, INC.

[Handwritten Signature]

Subscribed and sworn to before me, a Notary Public, in and for the County and State aforesaid, this 28th day of March, 1955.

[Handwritten Signature]
 Notary Public

My Commission Expires: March 5, 1958

PLUGGING
 FILE SEC 14 T 20 R 12W
 BOOK PAGE 102 LINE 6