

TYPE

AFFIDAVIT OF COMPLETION FORM

ACO-1 WELL HISTORY

SIDE ONE

Two (2) copies of this form shall be filed with the Kansas Corporation Commission, 200 Colorado Derby Building, Wichita, Kansas 67202, within thirty (30) days after the completion of a well, regardless of how the well was completed.

Attach separate letter of request if the information is to be held confidential. If confidential, only file one copy. Information on Side One will be of public record and Side Two will then be held confidential.


Applications must be made on dual completion, commingling, salt water disposal, injection and temporarily abandoned wells.

Attach one copy only wireline logs (i.e. electrical log, sonic log, gamma ray neutron log, etc.). (Rules 82-2-105 & 82-2-125) KCC# (316) 263-3238.

LICENSE # 5446 EXPIRATION DATE 6-30-84
 OPERATOR Benjamin M. Giles API NO. 15-009-20624
 ADDRESS 321 E. Williams COUNTY Barton Co.
Wichita 67202 FIELD TANKIA
 ** CONTACT PERSON Ben Giles PROD. FORMATION Kansas City
 316-262-4496 PHONE 321 E. Williams
 PURCHASER Rock Oil Co LEASE 1 Lookin
 ADDRESS Wichita KS WELL NO. 1
 DRILLING Duke Drilling Co WELL LOCATION NE 1/4 SE 1/4 SW
 CONTRACTOR Great Bend Kansas 990 Ft. from 1st Line and
 ADDRESS 2310 Ft. from 1st Line of
 the SW (Qtr.) SEC 4 TWP 20 RGE 12 W
 PLUGGING _____
 CONTRACTOR _____
 ADDRESS _____

TOTAL DEPTH 3394 PBTD _____
 SPUD DATE 3-28-83 DATE COMPLETED 3-29-83
 ELEV: GR 1811 DF 1813 KB 1816
 DRILLED WITH (CABLE) (ROTARY) (AIR) TOOLS.
 DOCKET NO. OF DISPOSAL OR REPRESSURING WELL BEING
 USED TO DISPOSE OF WATER FROM THIS LEASE
 Amount of surface pipe set and cemented OWWO - 219 ft 8 5/8 DV Tool Used? _____

THIS AFFIDAVIT APPLIES TO: (Circle ONE) - Oil Gas, Shut-in Gas, Dry, RECEIVED
 Injection, Temporarily Abandoned, OWWO Other _____
 ALL REQUIREMENTS OF THE STATUTES, RULES AND REGULATIONS PROMULGATED TO REGULATE THE OIL
 AND GAS INDUSTRY HAVE BEEN FULLY COMPLIED WITH.

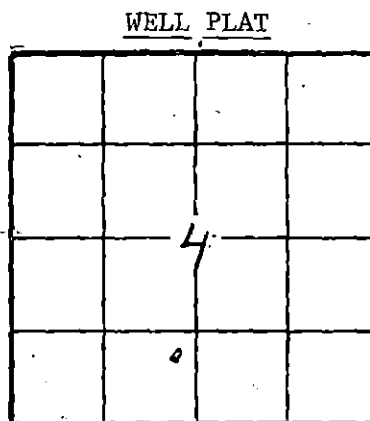

(Office Use Only)

KCC ☒
KGS ☒SWD/REP _____
PLG. _____

AFFIDAVIT

Benjamin M. Giles, being of lawful age, hereby certifies.

I am the Affiant, and I am familiar with the contents of the foregoing Affidavit. The statements and allegations contained therein are true and correct.

Benjamin M. Giles
 (Name)

SUBSCRIBED AND SWORN TO BEFORE ME this 15th day of September, 1983.

MY COMMISSION EXPIRES: January 28, 1985

H. Jean Keith
 (NOTARY PUBLIC)

** The person who can be reached by phone regarding any questions concerning this information.

STATE CORPORATION COMMISSION
 NOV 7 1983
 CONSERVATION DIVISION
 Wichita, Kansas

11-7-83

SIDE TWO

OPERATOR

Benjamin M. Giles LEASE

Tonkin

ACO-1 WELL HISTORY

SEC. 4 TWP. 20 RGE. 12 W

FILL IN WELL LOG AS REQUIRED:

Show all important zones of porosity and contents thereof; cored intervals, and all drill-stem tests, including depth interval tested, cushion used, time tool open, flowing and shut-in pressures, and recoveries.

SHOW GEOLOGICAL MARKERS, LOGS RUN, OR OTHER DESCRIPTIVE INFORMATION.

FORMATION DESCRIPTION, CONTENTS, ETC.	TOP	BOTTOM	NAME	DEPTH
N/A - Washdown			Log a Hatched	

Report of all strings set — surface, intermediate, production, etc. CASING RECORD (New) or (Used)

Purpose of string	Size hole drilled	Size casing set (in O.D.)	Weight lbs/ft.	Setting depth	Type cement	Sacks	Type and percent additives
Production Casing	7 7/8	5 1/2	14 lb	3393	Common	75	
					Pozmix	50	
					Salt	27	
					Allied Cementing		

LINER RECORD

PERFORATION RECORD

Top, ft.	Bottom, ft.	Sacks cement	Shots per ft.	Size & type	Depth interval
			2		3266-3270
Size	Setting depth	Packer set at			
2 3/8" O.D.	3300				

ACID, FRACTURE, SHOT, CEMENT SQUEEZE RECORD

Amount and kind of material used	Depth interval treated
250 gallons ^{1590 mud} acid Swabbed ^{4 hrs} 3 BFPH 80% oil	3266-3270
1500 gallons 28% acid Swabbed 8 BFPH 37% oil	
w good show of Gas POP	
Date of first production 8-21-83	Producing method (flowing, pumping, gas lift, etc.) Pumping
Gravity 38	
RATE OF PRODUCTION PER 24 HOURS 1st 24 hrs 53 Bbls Now 7 Bbls bbls.	Water 30% MCF bbls. Gas-oil ratio CFPB
Disposition of gas (vented, used on lease or sold) used on lease	Perforations 8 shots in 4 ft - 3266 to 3270

Declined