

STATE OF KANSAS
STATE CORPORATION COMMISSION


WELL PLUGGING RECORD

Give All Information Completely
Make Required Affidavit
Mail or Deliver Report to:
Conservation Division
State Corporation Commission
800 Bitting Building
Wichita, Kansas

OR
FORMATION PLUGGING RECORD

Strike out upper line
when reporting plugging
of formations.

NORTH

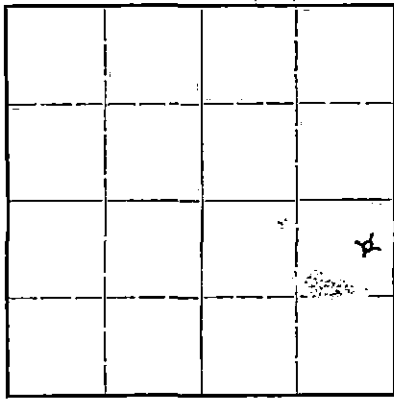

Locate well correctly on above
Section Plat

Barton County. Sec 1 Twp. 20 Rge. (E) 12 (W)
Location as "NE1/4NW1/4SW1/4" or footage from lines. CEL- NE - SE
Lease Owner. C. E. Ash
Lease Name. G. Ernsting Well No. 2
Office Address. 309 Petroleum Bldg.; Wichita 2, Kansas
Character of Well (completed as Oil, Gas or Dry Hole). Dry
Date well completed. June 7 19 46
Application for plugging filed. June 7 19 46
Application for plugging approved. June 7 19 46
Plugging commenced. June 7 19 46
Plugging completed. June 7 19 46
Reason for abandonment of well or producing formation. Dry

If a producing well is abandoned, date of last production. 19
Was permission obtained from the Conservation Division or its agents before plugging was commenced? Yes

Name of Conservation Agent who supervised plugging of this well. H. W. Kerr
Producing formation. Conglomerate Depth to top. 3335 Bottom. 3385 Total Depth of Well. 3385 Feet
Show depth and thickness of all water, oil and gas formations.

OIL, GAS OR WATER RECORDS


CASING RECORD

Formation	Content	From	To	Size	Put In	Pulled Out
Conglomerate		3335	3385	8-5/8	330	None

Describe in detail the manner in which the well was plugged, indicating where the mud fluid was placed and the method or methods used in introducing it into the hold. If cement or other plugs were used, state the character of same and depth placed, from _____ feet to _____ feet for each plug set.

Mudded from 3385' to 300' with rotary mud.
Set wood plug at 300'. 8' rock bridge 15 sacks cement.
Mudded to 45'. Set wood plug at 45' 10 sacks cement.
Filled to surface with dirt.

PLUGGING
1 20 R 320
AGE-57 LINE 44

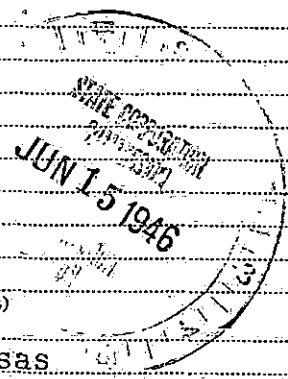

(If additional description is necessary, use BACK of this sheet)
Correspondence regarding this well should be addressed to C. E. ASH
Address. 309 Petroleum Building; Wichita 2, Kansas

STATE OF Kansas COUNTY OF Sedgwick ss.

C. E. Ash (owner or operator) of the above-described well,
being first duly sworn on oath, says: That I have knowledge of the facts, statements, and matters herein contained and the log of the above-described well as filed and that the same are true and correct. So help me God.

(Signature) C. E. Ash

(Address)

SUBSCRIBED AND SWORN to before me this 14th day of June, 19 46

My commission expires 9/10/1947
Notary Public.

C E Ash et al

G Ernsting #2

CEL-NE-SS Sec. 1-20-12W
Barton County, Kansas

Comm. Rig Up : 5-22-46
Comm. Drig. : 5-23-46
Completed : 6-5-46
Total Depth : 3385'

Elevation :
Initial Prod. : D & A
Contractor : C E Ash
Tools : Rotary

CASING RECORD

<u>Run</u>	<u>Pulled</u>	<u>Left In</u>
330' - 8-5/8" Surface		330' - 8-5/8" Surface

STRATA DEPTH

Sand	113
Shale & shells	340
Red bed & shells	565
Anhydrate lime	580
Red bed & shells	680
Shale & shells	1030
Salt	1245
Shale & shells	1395
Lime	1645
Shale	1675
Sand	1700
Lime	1705
Lime & shale	2690
Lime	2970
Shale & lime	3070
Lime	3353
Various color shale	3385
Total Depth	3385

FORMATION TOPS- Rotary Bushings

Brown Line	3065
KC or White Line	3086
Conglomerate	3337

I hereby certify that the above is the true and correct log of said well as reflected by the daily drilling reports.

C E Ash

Subscribed in my presence and sworn to before me this 14th day of June, 1946.

Notary Public in and for Sedgwick County, Kansas.

My commission expires September 10, 1947

PLUGGING
FILE SEC. 1-20-12W
BOOK PAGE 57-44

