


WELL PLUGGING RECORD

Give All Information Completely
Make Required Affidavit
Mail or Deliver Report to:
Conservation Division
State Corporation Commission
211 No. Broadway
Wichita, Kansas

Barton County. Sec. 1 Twp. 20S Rge. 12W (E) (W)

T 20S NORTH R 12W

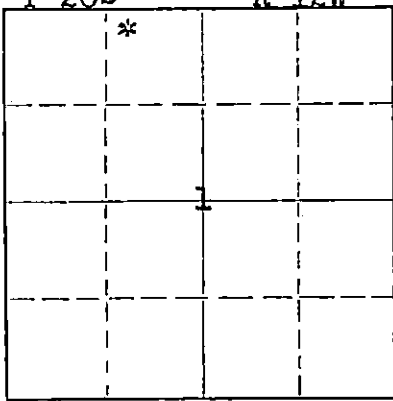

Locate well correctly on above Section Plat

Location as "NE/CNW/SW" or footage from lines NW NE NW
Lease Owner E. K. Edmiston
Lease Name Wolf Well No. 2
Office Address 523 Union Nat'l. Bank - Wichita, Kansas
Character of Well (completed as Oil, Gas or Dry Hole) Dry Hole
Date well completed December 18 19 56
Application for plugging filed January 17 19 57
Application for plugging approved _____ 19 _____
Plugging commenced January 18 19 57
Plugging completed January 25 19 57
Reason for abandonment of well or producing formation _____

If a producing well is abandoned, date of last production _____ 19 _____
Was permission obtained from the Conservation Division or its agents before plugging was commenced? Yes

Name of Conservation Agent who supervised plugging of this well Brundege
Producing formation _____ Depth to top _____ Bottom _____ Total Depth of Well 3376 Feet
Show depth and thickness of all water, oil and gas formations.

OIL, GAS OR WATER RECORDS

CASING RECORD

FORMATION	CONTENT	FROM	TO	SIZE	PUT IN	PULLED OUT
				8-5/8"	205'	None
				5-1/2"	3347'	2451'
				Plugged back to 3165' and perforated at 3086'.		

Describe in detail the manner in which the well was plugged, indicating where the mud fluid was placed and the method or methods used in introducing it into the hole. If cement or other plugs were used, state the character of same and depth placed, from _____ feet to _____ feet for each plug set.

Filled the hole with sand from 3165' to 3075' and ran 5 sacks of cement. Filled surface pipe to top by pumping in 25 sacks of jell mud and 75 sacks of cement. Plugging completed.

(If additional description is necessary, use BACK of this sheet)

Name of Plugging Contractor West Supply Co., Inc.
Address Chase, Kansas

STATE OF _____ COUNTY OF _____, ss.

(employee of owner) or (owner or operator) of the above-described well, being first duly sworn on oath, says: That I have knowledge of the facts, statements, and matters herein contained and the log of the above-described well as filed and that the same are true and correct. So help me God.

(Signature) [Signature]
(Address) _____

SUBSCRIBED AND SWORN TO before me this 28th day of January, 1957

My commission expires August 22, 1957

[Signature] Notary Public.
RECEIVED
STATE CORPORATION COMMISSION

PLUGGING
FILE SEC 1 T 20 R 12W
BOOK PAGE 134 LI. E. 45

JAN 29 1957
CONSERVATION DIVISION
Wichita, Kansas

COMPANY: E. K. Edmiston
523 Union National Building
Wichita, Kansas

Rotary Drilling Commenced: 12-6-56
Rotary Drilling Completed: 12-18-56

LOCATION: Wolf No. 2
NW NE NW 1-20S-12W
Barton County, Kansas

CONTRACTOR: Shelley-Miller Drilling Company
205 Miller Building
Wichita, Kansas

CASING RECORD: 8 5/8 24# Casing set @ 205', cemented with
150 sacks cement.

5 1/2 14# Casing set @ 3347, cemented with
100 sacks cement.

LOG

(Measurements from top of Rotary Bushing to bottom of formation)

Sand	50
Hard Sand	79
Sand	130
Hard Sand	132
Sand	150
Shale & Clay	205
Shale	490
Red Bed	850
Shale and Shells	1,365
Lime and Shale	2,190
Shale and Shells	2,385
Lime and Shale	2,685
Lime	3,350 Rotary T.D.

RECEIVED
STATE CORPORATION COMMISSION
CONSERVATION DIVISION
Wichita, Kansas

The undersigned, Richard A. Shelley, Partner of Shelley-Miller Drilling Company, hereby certifies in behalf of said company, that the above log is a true and correct log of the formation encountered in drilling the above well as reflected by the Daily Drilling Reports.

SHELLEY-MILLER DRILLING COMPANY

By Richard A. Shelley

STATE OF KANSAS)
COUNTY OF SEDGWICK) SS

BE IT REMEMBERED, that on this 15th day of January, 1957, before me the undersigned, a Notary Public, duly commissioned in and for the county and state aforesaid, came Richard A. Shelley, Partner, and known to me to be the same person who executed the foregoing instrument of writing in behalf of Shelley-Miller Drilling Company, as a Partner of said company, and he duly acknowledged the execution of the same for himself and for said company.

IN WITNESS WHEREOF, I have hereunto set my hand and official seal on the day and year last above written.

Leona M. Lower
Notary Public

My Commission Expires:
March 24, 1960

PLUGGING
FILE SEC 1 T 20 R 12 W
BOOK PAGE 134 LINE 45