


WELL PLUGGING RECORD

Give All Information Completely
Make Required Affidavit
Mail or Deliver Report to:
Conservation Division
State Corporation Commission
211 No. Broadway
Wichita, Kansas

Barton SE-NE-SW County: Sec. 2 Twp. 20 Rge. 12 (E) (W)

Location as "NE/CNW&SW" or footage from lines: SE-NE-SW
Lease Owner: Shelley - Miller Bldg. Wichita
Lease Name: Knopp Well No. 2
Office Address: 205 Miller Bldg. Wichita
Character of Well (completed as Oil, Gas or Dry Hole): Oil
Date well completed: 7-20-60 19
Application for plugging filed: 19
Application for plugging approved: 19
Plugging commenced: 7-19- 1962
Plugging completed: 7-24 1962
Reason for abandonment of well or producing formation:

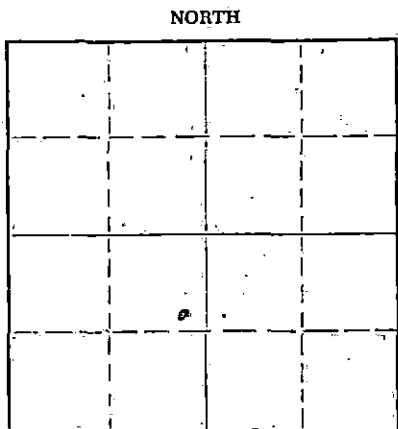

Locate well correctly on above Section Plat

If a producing well is abandoned, date of last production: 7-14 1962
Was permission obtained from the Conservation Division or its agents before plugging was commenced? yes

Name of Conservation Agent who supervised plugging of this well: Gilbert Leiker
Producing formation: arb. Depth to top: 3357 Bottom: 3375 Total Depth of Well: 3375 Feet
Show depth and thickness of all water, oil and gas formations.

OIL, GAS OR WATER RECORDS

CASING RECORD

FORMATION	CONTENT	FROM'	TO	SIZE	PUT IN	PULLED OUT
<u>arb.</u>	<u>2 1/2" oil</u>	<u>3367</u>	<u>3375</u>	<u>4 1/2"</u>	<u>3367</u>	<u>2802</u>
	<u>7 1/2" water</u>					
				<u>8 5/8"</u>	<u>1894</u>	

Describe in detail the manner in which the well was plugged, indicating where the mud fluid was placed and the method or methods used in introducing it into the hole. If cement or other plugs were used, state the character of same and depth placed, from _____ feet to _____ feet for each plug set.

Mudded hole to 199'. Set 10' rock bridge from 199' to 189'. Mixed and dumped 20 ex. of cement from 189' to 129'. Mudded hole from 129' to 35'. Set 5' rock bridge from 35' to 30'. Mixed & dumped 100 ex. of cement from 30' to base of cellar.

RECEIVED
STATE CORPORATION COMMISSION
AUG 15 1962
CONSERVATION DIVISION
Wichita, Kansas

Name of Plugging Contractor: Ace Pipe Drilling Co.
Address: Box 304 Great Bend Kansas

STATE OF KANSAS COUNTY OF SEDGWICK, ss.

Richard A. Shelley (employee of owner) or (owner or operator) of the above-described well, being first duly sworn on oath, says: That I have knowledge of the facts, statements, and matters herein contained and the log of the above-described well as filed and that the same are true and correct. So help me, God.

(Signature) Richard A. Shelley
205 Miller Bldg., Wichita, Kansas
(Address)

SUBSCRIBED AND SWORN to before me this 14 day of August, 19 62

My commission expires March 24, 1964
Leon M. Powers Notary Public.