

STATE OF KANSAS
STATE CORPORATION COMMISSION


WELL PLUGGING RECORD

Give All Information Completely
Make Required Affidavit
Mail or Deliver Report to
Conservation Division
State Corporation Comm.
245 North Water
Wichita, KS 67202

Barton County. Sec. 2 Twp. 20 Rge. 12W E/W
Location as "NE/CNW $\frac{1}{2}$ /SW $\frac{1}{4}$ " or footage from lines NE SW NE

Lease Owner Davis and Reed
Lease Name Ahlgrim Well No. 2

Office Address 645 Fourth Financail Center, Wichita, Ks.
Character of Well (Completed as Oil, Gas or Dry Hole) Dry Hole

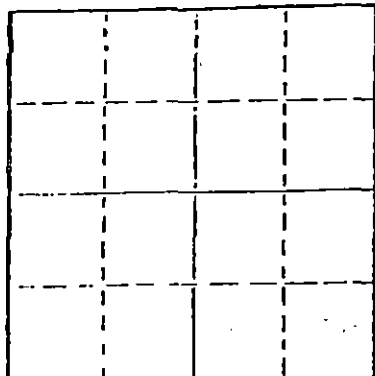

Locate well correctly on above
Section Plot

Date Well completed May 16 1976
Application for plugging filed May 16 1976
Application for plugging approved May 16 1976
Plugging commenced May 16 1976
Plugging completed May 16 1976
Reason for abandonment of well or producing formation Dry Hole

If a producing well is abandoned, date of last production 19

Was permission obtained from the Conservation Division or its agents before plugging was commenced? yes

Name of Conservation Agent who supervised plugging of this well Duane Rankin
Producing formation _____ Depth to top _____ Bottom _____ Total Depth of Well 3387

Show depth and thickness of all water, oil and gas formations.

OIL, GAS OR WATER RECORDS

CASING RECORD

FORMATION	CONTENT	FROM	TO	SIZE	PUT IN	PULLED OUT

Describe in detail the manner in which the well was plugged, indicating where the mud fluid was placed and the method or methods used in introducing it into the hold. If cement or other plugs were used, state the character of same and depth placed, from _____ feet to _____ feet for each plug set.

Bottom plug @ 500' w/50 sacks cement, thru drill pipe.
Middle plug @ 225' w/25 sacks cement thru drill pipe.
Top plug @ 40' w/10 sacks cement. $\frac{1}{2}$ sack hulls
2 sacks cement in rat hole.

1 sack cement in water well.

RECEIVED
STATE CORPORATION COMMISSION
5-20-76
MAY 20 1976

CONSERVATION DIVISION
Wichita, Kansas

(If additional description is necessary, use BACK of this sheet)

Name of Plugging Contractor Duke Drilling Co.

STATE OF KANSAS COUNTY OF BARTON, ss.

Larry Curtis (employee of owner) or (owner or operator)
of the above-described well, being first duly sworn on oath, says: That I have knowledge of the facts, statements, and matters herein contained and the log of the above-described well as filed and that the same are true and correct. So help me God.

(Signature) Larry Curtis
Box 823, Great Bend, Ks.
(Address)

SUBSCRIBED AND SWORN TO before me this 17th day of May, 1976

Clarity M. Hogue
Notary Public.

My commission expires April 11, 1978


STATE OF KANSAS
STATE CORPORATION COMMISSION

WELL PLUGGING RECORD

Give All Information Completely.
Make Required Affidavit
Mail or Deliver Report to
Conservation Division
State Corporation Comm.
245 North Water
Wichita, KS 67202

Barton County, Sec. 2 Twp. 20 Rge. 12W / E/W
Location as "NE/CNW SW 1/4" or footage from lines
NE SW NE

Lease Owner Davis and Reed
Lease Name Algrim Well No. 2
Office Address 645 Fourth Financial Center, Wichita, Ks.
Character of Well (Completed as Oil, Gas or Dry Hole) Dry Hole

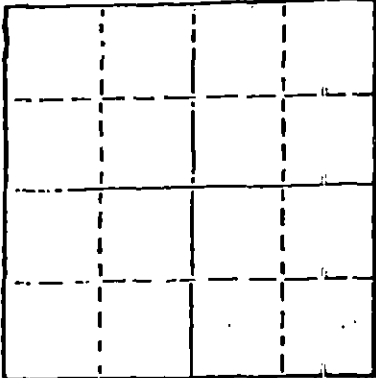

Locate well correctly on above Section Plot

Date Well completed May 16 1976
Application for plugging filed May 16 1976
Application for plugging approved May 16 1976
Plugging commenced May 16 1976
Plugging completed May 16 1976

Reason for abandonment of well or producing formation Dry Hole
If a producing well is abandoned, date of last production 19

Was permission obtained from the Conservation Division or its agents before plugging was commenced? yes

Name of Conservation Agent who supervised plugging of this well Duane Rankin
Producing formation _____ Depth to top _____ Bottom _____ Total Depth of Well 3387
Show depth and thickness of all water, oil and gas formations.

OIL, GAS OR WATER RECORDS

CASING RECORD

FORMATION	CONTENT	FROM	TO	SIZE	PUT IN	PULLED OUT

Describe in detail the manner in which the well was plugged, indicating where the mud fluid was placed and the method or methods used in introducing it into the hold. If cement or other plugs were used, state the character of same and depth placed, from _____ feet to _____ feet for each plug set.

Bottom plug @ 500' w/50 sacks cement, thru drill pipe.
Middle plug @ 225' w/25 sacks cement thru drill pipe.
Top plug @ 40' w/10 sacks cement. 1/2 sack hulls
2 sacks cement in rat hold.
1 sack cement in water well.

(If additional description is necessary, use BACK of this sheet)

Name of Plugging Contractor Duke Drilling Co.

STATE OF KANSAS COUNTY OF BARTON, ss.

Larry Curtis (employee of owner) or (~~owner~~)
of the above-described well, being first duly sworn on oath, says: That I have knowledge of the facts, statements, and matters herein contained and the log of the above-described well as filed and that the same are true and correct. So help me God.

(Signature) Larry Curtis
Box 823, Great Bend, Ks.
(Address)

SUBSCRIBED AND SWORN TO before me this 17th day of May, 19 76

My commission expires April 11, 1978
Rowdy M. Wagner Notary Public.

DRILLERS' WELL LOG

DATE COMMENCED: MAY 7, 1976
DATE COMPLETED: MAY 16, 1976

Davis and Reed
AHLGRIM # 2
NE SW NE of Sec 2-T20-RL2W
Barton County, Kansas

ELEVATION: 1800 K.B.

0 - 153'	Sand and Shale
153 - 155'	Hard Sand
155 - 290'	Shale
290 - 595'	Red Bed
595 - 606'	Anhydrite
606 - 1380'	Shale
1380 - 2951'	Lime and Shale
2951 - 2956'	Shale
2956 - 2966'	Lime and Shale
2966 - 2983'	Lime
2983 - 3071'	Shale
3071 - 3085'	Lime and Shale
3085 - 3325'	Lime
3325 - 3336'	Lime and Shale
3336 - 3387'	Dolomite
3387'	RTD

FORMATION TOPS

Anhydrite	595
Heebner	2951
Toronto	2966
Douglas	2983
Brown Lime	3071
Lansing K.C.	3085
Base K.C.	3325
Arbuckle	3336
RTD	3387

SURFACE PIPE:

Set used 8 5/8", 28# pipe @ 206'
w/185 sacks 50/50 Pozmix, 2% Gel,
3% cc.

RECEIVED
STATE OF KANSAS COMMISSIONER
MAY 20 1976
CONSERVATION DIVISION
Wichita, Kansas

A F F I D A V I T

STATE OF KANSAS)
COUNTY OF BARTON) ss.

Larry Curtis, of lawful age, does swear and state that the facts and statements herein contained are true and correct to the best of his knowledge.

Larry Curtis

Subscribed and sworn to before me this 19th day of May, 1976.

Deborah M. Hogue
Notary Public

My Commission Expires: April 11, 1978