


STATE OF KANSAS
STATE CORPORATION COMMISSION

Form CP-4

Give All Information Completely
Make Required Affidavit
Mail or Deliver Report to:
Conservation Division
State Corporation Commission
211 No. Broadway
Wichita, Kansas

WELL PLUGGING RECORD

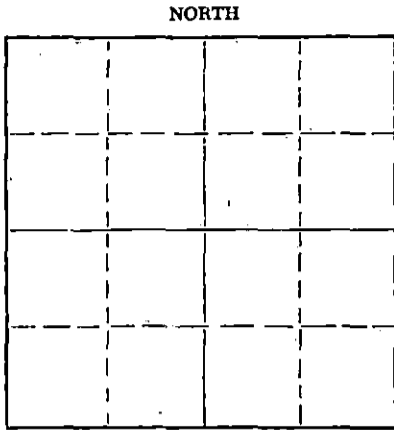

Locate well correctly on above
Section Plat

Rice County, Sec. 4 Twp. 20S Rge. 7W (BX) (W)
Location as "NE/CNWxSWx" or footage from lines 990' FWL, 330' ESL, C SW SE SE
Lease Owner The Pyramid Corporation, Inc.
Lease Name Engelland Well No. 1
Office Address Suite 110, 3000 W. Kellogg Drive, Wichita, Kansas 67213
Character of Well (completed as Oil, Gas or Dry Hole) Dry Hole
Date well completed February 9, 1972 19
Application for plugging filed February 9, 1972 19
Application for plugging approved February 9, 1972 19
Plugging commenced 4:00 PM, February 9, 1972 19
Plugging completed 5:30 PM, February 9, 1972 19
Reason for abandonment of well or producing formation Dry Hole

If a producing well is abandoned, date of last production 19
Was permission obtained from the Conservation Division or its agents before plugging was commenced? Yes

Name of Conservation Agent who supervised plugging of this well Gilbert Toman
Producing formation Depth to top Bottom Total Depth of Well 3665' Feet
Show depth and thickness of all water, oil and gas formations.

OIL, GAS OR WATER RECORDS

CASING RECORD

FORMATION	CONTENT	FROM	TO	SIZE	PUT IN	PULLED OUT
				8 5/8"	221'	None

Describe in detail the manner in which the well was plugged, indicating where the mud fluid was placed and the method or methods used in introducing it into the hole. If cement or other plugs were used, state the character of same and depth placed, from feet to feet for each plug set.

Filled hole with heavy mud to 215' -
Halliburton plug and 1/2 sacks hulls and
25 sacks cement. Filled hole to 40' -
Halliburton plug and 1/2 sack hulls and
10 sacks cement. 2 sacks cement in rathole.

RECEIVED
STATE CORPORATION COMMISSION
FEB 18 1972
CONSERVATION DIVISION
Wichita, Kansas

(If additional description is necessary, use BACK of this sheet)
Name of Plugging Contractor Sterling Drilling Company
Address P. O. Box 129, Sterling, Kansas 67579

STATE OF KANSAS, COUNTY OF RICE, ss.
F. A. Wuellner (employee of owner) or (owner or operator) of the above-described well, being first duly sworn on oath, says: That I have knowledge of the facts, statements, and matters herein contained and the log of the above-described well as filed and that the same are true and correct. So help me God. STERLING DRILLING COMPANY

(Signature) F. A. Wuellner, Secretary
P. O. Box 129, Sterling, Kansas 67579
(Address)

SUBSCRIBED AND SWORN to before me this 16th day of February, 19 72.

Bernard Laudermilk
Bernard Laudermilk, Notary Public.

My commission expires BERNARD LAUDERMILK - NOTARY PUBLIC
Commission Expires Jan. 22, 1974

STERLING DRILLING COMPANY
P. O. Box 129
Sterling, Kansas 67579

WELL LOG ----- ENGELLAND #1

Located: 990' FWL, 330' FSL, C SW SE SE, Section 4-20S-7W
Rice County, Kansas

OWNER: The Pyramid Corporation
ROTARY DRILLING CONTRACTOR: Sterling Drilling Company

COMMENCED: February 1, 1972
COMPLETED: February 9, 1972

TOTAL DEPTH: 3665'

<u>LOG</u>	
0 - 185	Clay and Shale
185 - 225	Shale
225 - 1000	Red Bed - Shale
1000 - 1065	Salt and Shale
1065 - 2095	Lime and Shale
2095 - 3155	Lime
3155 - 3218	Lime and Shale
3218 - 3227	Lime
3227 - 3498	Shale and Lime
3498 - 3520	Sand and Lime and Shale
3520 - 3583	Lime and Shale
3583 - 3613	Sand Shale
3613 - 3624	Shale and Lime
3624 - 3665	Arbuckle

CASING RECORD

Ran 5 joints 8 5/8" casing, 209.54' cemented at 221' KB with 175 sacks 60/40 Pozmix 3% HA-5. Plug down at 5:00 PM, 2-1-72.

Plugged.

RECEIVED
STATE CORPORATION COMMISSION
FEB 18 1972
CONSERVATION DIVISION
Wichita, Kansas