

STATE OF KANSAS
STATE CORPORATION COMMISSION

Give All Information Completely
Make Required Affidavit
Mail or Deliver Report to:
Conservation Division
State Corporation Commission
211 No. Broadway
Wichita, Kansas

WELL PLUGGING RECORD

Rice

County. Sec. 4 Twp. 20S Rge. 7W (E) (W)

Location as "NE/CNW/SW" or footage from lines NE NE SW

Lease Owner Sterling Drilling Company and M. O. Henry, et al

Lease Name Smith Well No. 1

Office Address Box 127, Sterling, Kansas 67579

Character of Well (completed as Oil, Gas or Dry Hole) Dry Hole

Date well completed August 6, 1964 19

Application for plugging filed August 6, 1964 19

Application for plugging approved August 6, 1964 19


Plugging commenced August 6, 1964 19

Plugging completed August 6, 1964 19

Reason for abandonment of well or producing formation Dry

If a producing well is abandoned, date of last production _____ 19

Was permission obtained from the Conservation Division or its agents before plugging was commenced? yes

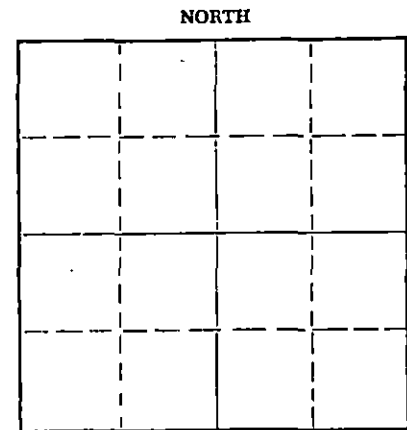

Locate well correctly on above Section Plat

Name of Conservation Agent who supervised plugging of this well Gilbert Toman

Producing formation _____ Depth to top _____ Bottom _____ Total Depth of Well 3685 Feet

Show depth and thickness of all water, oil and gas formations.

OIL, GAS OR WATER RECORDS

CASING RECORD

FORMATION	CONTENT	FROM	TO	SIZE	PUT IN	PULLED OUT
				8 5/8"	206.33'	
					set at 214.33'	None

Describe in detail the manner in which the well was plugged, indicating where the mud fluid was placed and the method or methods used in introducing it into the hole. If cement or other plugs were used, state the character of same and depth placed, from _____ feet to _____ feet for each plug set.

Heavy mud up to 200'. Plug at 200', 20 sacks cement. Heavy mud to 40'. Plug at 40', 10 sacks cement.

2 sacks cement in rat hole.

RECEIVED
STATE CORPORATION COMMISSION

AUG 12 1964

CONSERVATION DIVISION
Wichita, Kansas

(If additional description is necessary, use BACK of this sheet)

Name of Plugging Contractor Group Exploration Company

Address Sterling, Kansas 67579

STATE OF KANSAS, COUNTY OF RICE, ss. F. A. Wuellner

(employee of owner) or (owner or operator) of the above-described well, being first duly sworn on oath, says: That I have knowledge of the facts, statements, and matters herein contained and the log of the above-described well as filed and that the same are true and correct. So help me God. **STERLING DRILLING COMPANY**

(Signature) [Signature]

F. A. Wuellner, Secretary
(Address)

SUBSCRIBED AND SWORN to before me this 11th day of August, 19 64

My commission expires My commission expires January 6, 1966

Charles M. Hall
Charles M. Hall Notary Public.

GROUP EXPLORATION COMPANY
Sterling, Kansas

WELL LOG - - - - - SMITH #1

Located: NE NE SW Section 4-20S-7W, Rice County, Kansas

Owner: Sterling Drilling Company and M. O. Henry, et al

Rotary Drilling Contractor: Group Exploration Company

Commenced: 7-28-64

Completed: 8-6-64

Rotary Total Depth: 3685'

RECEIVED
STATE CORPORATION COMMISSION
AUG 12 1964
CONSERVATION DIVISION
Wichita, Kansas

Log

0-217	Clay & Shale
217-920	Shale
920-2334	Shale & Lime
2334-2440	Shale
2440-2585	Lime
2585-2870	Lime & Shale
2870-3278	Lime
3278-3509	Shale & Lime
3509-3513	Sand
3513-3580	Lime
3580-3635	Lime & Shale
3635-3685	Lime

T.D.

Casing Record

Set 8-5/8" Surface Casing @
214.33 K.B. With 175 Sacks 50-50
Pozmix with HA5

Plugged & Abandoned