


STATE OF KANSAS
STATE CORPORATION COMMISSION

WELL PLUGGING RECORD

Give All Information Completely
Make Required Affidavit
Mail or Deliver Report to:
Conservation Division
State Corporation Commission
800 Bittling Building
Wichita, Kansas

OR
FORMATION PLUGGING RECORD Strike out upper line when reporting plugging of formations.

Barton County. Sec. 11 Twp. 20 Rge. (E) 14 (W)
Location as "NE $\frac{1}{4}$ NW $\frac{1}{4}$ SW $\frac{1}{4}$ " or footage from lines. SE SE SE
Lease Owner. Edwin G. Bradley, et al
Lease Name. Unruh Well No. 1
Office Address. R.F.D. #3 Wichita, Kansas
Character of Well (completed as Oil, Gas or Dry Hole) Dry Hole
Date well completed. 11/9 1948
Application for plugging filed. 11/9 1948
Application for plugging approved. 11/9 1948
Plugging commenced. 11/9 1948
Plugging completed. 11/9 1948
Reason for abandonment of well or producing formation.

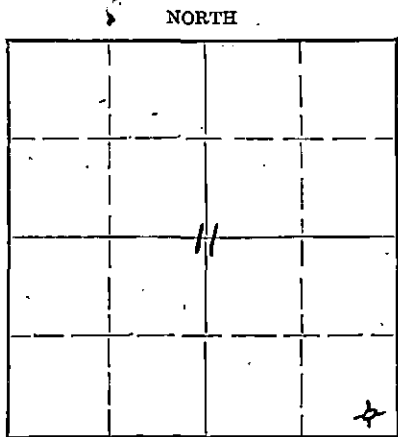

Locate well correctly on above Section Plat

If a producing well is abandoned, date of last production. 19
Was permission obtained from the Conservation Division or its agents before plugging was commenced? Yes

Name of Conservation Agent who supervised plugging of this well Mr. Stowe authority J. P. Roberts
Producing formation. Depth to top. Bottom. Total Depth of Well. 3571 Feet
Show depth and thickness of all water, oil and gas formations.

OIL, GAS OR WATER RECORDS

CASING RECORD

Formation	Content	From	To	Size	Put In	Pulled Out
				8 5/8"	803'	None

Describe in detail the manner in which the well was plugged, indicating where the mud fluid was placed and the method or methods used in introducing it into the hole. If cement or other plugs were used, state the character of same and depth placed, from _____ feet to _____ feet for each plug set.

Jetted pits and circulated heavy mud thirty minutes - laid down 1800'
drill pipe - filled hole with heavy mud - laid down balance drill pipe -
filled hole with heavy mud to 800' - placed wood plug at 800' and run
15 sax cement on this plug - filled hole with heavy mud to 25' - second
wood plug and filled with cement to base of cellar

RECEIVED
NOV 12 1948
STATE CORPORATION COMMISSION
KANSAS
11-12-48

(If additional description is necessary, use BACK of this sheet)

Correspondence regarding this well should be addressed to Edwin G. Bradley
Address R.F.D. #3 Wichita, Kansas

STATE OF Kansas COUNTY OF Sedgwick, ss.

I, W. W. Wright (employee of owner) or (owner or operator) of the above-described well, being first duly sworn on oath, says: That I have knowledge of the facts, statements, and matters herein contained and the log of the above-described well as filed and that the same are true and correct. So help me God.

(Signature) W. W. Wright

708 Fourth Nat'l Bldg., Wichita 2, Kans.
(Address)

SUBSCRIBED AND SWORN to before me this 10th day of November, 1948

Ronald Koch
Notary Public.

My commission expires June 7, 1952.

PLUGGING
FILE SEC. 11 T. 20 R. 14
BOOK PAGE 67-44

WELL LOG UNRUH NO. 1

Ed. Bradley, et al - Lease Owners

Sec. 11, Twp. 20, Range 14W

Donald T. Ingling - Contractor

Location: SE SE SE

Total Depth: 3571' (Rotary)

County: Barton (Kansas)

Commenced: October 22, 1948

Elevation: 1878 D.F.

Completed: November 9, 1948

Production:

Casing: 803' of 8 5/8"

Figures below indicated bottom of formation:

160	Sand	3105	Lime
275	Shale & Shells	3150	Lime (Shale Streaks)
295	Sand	3200	Lime & Shale
550	Shale & Shells	3225	Shale
794	Red Rock & Shale	3258	Shale & Lime
845	Anhydrite	3471	Lime
1260	Shale & Shells	3551	Conglomerate
1550	Salt & Shale	3571	Arbuckle Lime
1770	Shale & Shells		
2830	Lime & Shale	3571	TOTAL DEPTH
2875	Shale		

I hereby certify that this is a true and correct log of the abovementioned well.

DONALD T. INGLING

W. J. Wright

STATE OF KANSAS |
 | ss.
SEDGWICK COUNTY |

Subscribed and sworn to before me, a Notary Public in said County and State this 10th day of November 1948.

RECEIVED
Rosamond Koch
Notary Public
NOV 12 1948

My Commission Expires: June 7, 1952

PLUGGING
FILE SEC 11 T20 R14W
BOOK PAGE 67 LINE 44

STATE CORPORATION
COMMISSION
KANSAS