


WELL PLUGGING RECORD

Give All Information Completely
Make Required Affidavit
Mail or Deliver Report to:
Conservation Div.
State Corporation Commission
211 No. Broadway
Wichita, Kansas

Rice County, Sec. 34 Twp. 20 Rge. 9 (E) W (W)

Location as "NE/CNW/SW" or footage from lines NE NW SW
Lease Owner Muir-Thompson, Inc.
Lease Name Vincent Well No. 1
Office Address 820 Quincy St., Topeka, Kansas
Character of Well (completed as Oil, Gas or Dry Hole) Dry hole
Date well completed 10/27/62 19
Application for plugging filed 10/27/62 Verbally 19
Application for plugging approved 10/27/62 Verbally 19
Plugging commenced 10/27/62 @10:30 A.M. 19
Plugging completed 12:30 P.M. 10/27/62 19
Reason for abandonment of well or producing formation _____

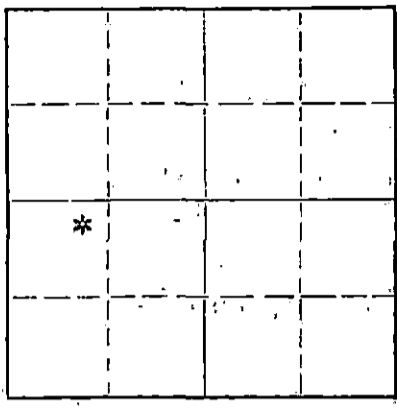

Locate well correctly on above Section Plat

If a producing well is abandoned, date of last production _____ 19
Was permission obtained from the Conservation Division or its agents before plugging was commenced? Yes

Name of Conservation Agent who supervised plugging of this well Gilbert Toman, Holyrood, Kansas
Producing formation _____ Depth to top _____ Bottom _____ Total Depth of Well 3455 Feet
Show depth and thickness of all water, oil and gas formations.

OIL, GAS OR WATER RECORDS

CASING RECORD

FORMATION	CONTENT	FROM	TO	SIZE	PUT IN	PULLED OUT
		0	205	8 5/8"	205	None

Describe in detail the manner in which the well was plugged, indicating where the mud fluid was placed and the method or methods used in introducing it into the hole. If cement or other plugs were used, state the character of same and depth placed, from _____ feet to _____ feet for each plug set.

Mudded 3455 to 200'
Set plug @200' plus 1/2 sack hulls,
Run 20 sacks cement,
Mudded to 35'
Set plug @35' plus 1/2 sack hulls,
Run 10 sacks cement to bottom of cellar,
Run 2 sacks cement in rathole, filled w/ soil.

RECEIVED
STATE CORPORATION COMMISSION

NOV 15 1962 11-16-62

CONSERVATION DIVISION
Wichita, Kansas

(If additional description is necessary, use BACK of this sheet)
Name of Plugging Contractor Bea Drilling Co., Inc.
Address Box 247, Ellinwood, Kansas

STATE OF Kansas COUNTY OF Barton, ss.
C. F. Krehbiel (employee of owner) or (owner or operator) of the above-described well, being first duly sworn on oath, says: That I have knowledge of the facts, statements, and matters herein contained and the log of the above-described well as filed and that the same are true and correct. So help me God.
(Signature) C. F. Krehbiel
Box 247, Ellinwood, Kansas (Address)

SUBSCRIBED AND SWORN TO before me this 31st day of October, 1962
My commission expires November 15, 1962
Thelma S. Cook
Notary Public.

W E L L L O G

Muir-Thompson, Inc.
#1 Vincent
NE NW SW Sec. 34-20S-9W
Rice County, Kansas

Contractor:
Bea Drilling Co., Inc.
Box 247, Ellinwood, Ks.

Date Staked: 10/16/62
Date Started: 10/17/62
Set surface: 10/18/62
Completed: 10/27/62

Elevation: 1691 Gr 1693 DF 1696 RB

Formation Tops:

Casing Record: 10 jts,
205.10' of 28# 8 5/8"
casing cemented w/175
sacks, plus 2 c.c, 1
aquagel, circulated.
Completed 1 A.M.

Heebner	2781
Brown lime	2919
Lansing-Kansas City	2947
Conglomerate	3284
Viola	3319
Simpson	3360
Arbuckle	3435
Rotary TD	3455

Drillers Log

(All measurements to bottom of formations.)

Surface sand, shale	176
Red bed	270
Anhydrite	295
Blue & grey shale	950
Shale & shells	1200
Sdy lime & shale	1364
Sand & shale	1510
Lime & shale	2140
Shale & shells	2255
Shale & lime	2345
Lime & shale	2602
Lime & shale	2880
Lime	2990
Shale & lime	3075
Lime	3191
Lime & shale	3265
Lime	3370
Shale & Lime	3383
Lime	3395
Lime & shale	3410
Shale & Arb. lime	3455
TD	3455

I hereby certify that the above is a true and correct log of said well as reflected by the daily drilling reports.

C. F. Krehbiel
C. F. Krehbiel, Vice-Pres.
Bea Drilling Co., Inc.

STATE OF KANSAS, COUNTY OF BARTON, ss.

Subscribed and sworn to before me this 31st day of
October, 1962.

Thelma L. Cook
Notary Public

My Commission expires November 15, 1962