


15.159.20456.0000

STATE OF KANSAS  
STATE CORPORATION COMMISSION

Form CP-4

Give All Information Completely  
Make Required Affidavit  
Mail or Deliver Report to:  
Conservation Division  
State Corporation Commission  
P. O. Box 17027  
Wichita, Kansas 67217  
NORTH

WELL PLUGGING RECORD

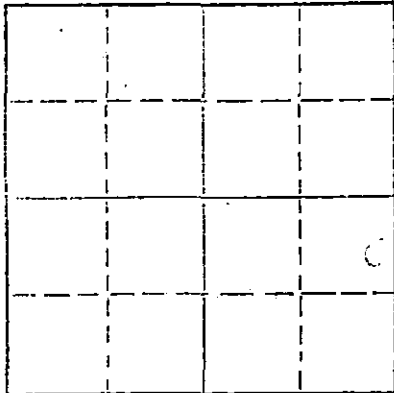

Locate well correctly on above  
Section Plat

Rice County, Sec. 30 Twp. 20 Rge. 9 (E) West (W)  
Location as "NE/CNW/SW" or footage from lines NE/4 NW/4 SE/4  
Lease Owner Icer Addis  
Lease Name JOHN CAYWOOD Well No. 3  
Office Address 312 Petroleum Building - Wichita, Kansas 67202  
Character of Well (completed as Oil, Gas or Dry Hole) Dry Hole  
Date well completed January 31, 19 73  
Application for plugging filed " " 19 73  
Application for plugging approved " " 19 73  
Plugging commenced January 31 19 73  
Plugging completed " " 19 73  
Reason for abandonment of well or producing formation \_\_\_\_\_

If a producing well is abandoned, date of last production 19 \_\_\_\_\_  
Was permission obtained from the Conservation Division or its agents before plugging was commenced? yes

Name of Conservation Agent who supervised plugging of this well Hugh Scott  
Producing formation \_\_\_\_\_ Depth to top \_\_\_\_\_ Bottom \_\_\_\_\_ Total Depth of Well 3290 Feet  
Show depth and thickness of all water, oil and gas formations.

OIL, GAS OR WATER RECORDS

CASING RECORD

| FORMATION | CONTENT | FROM | TO | SIZE | PUT IN | PULLED OUT |
|-----------|---------|------|----|------|--------|------------|
|           |         |      |    |      |        |            |
|           |         |      |    |      |        |            |
Describe in detail the manner in which the well was plugged, indicating where the mud fluid was placed and the method or methods used in introducing it into the hole. If cement or other plugs were used, state the character of same and depth placed, from \_\_\_\_\_ feet to \_\_\_\_\_ feet for each plug set.

Hole full of heavy mud to 500'  
Set Plug, with 25 sacks cement, thru drill pipe.  
Come up hole to 210' - Set plug with 25 sacks cement.  
Come up hole to 40' - 1/2 sacks hulls - Plug and 10 sacks cement.  
2 sacks cement in rat hole.

RECEIVED  
STATE CORPORATION COMMISSION  
FEB 5 1973  
CONSERVATION DIVISION  
Wichita, Kansas

(If additional description is necessary, use BACK of this sheet)

Name of Plugging Contractor \_\_\_\_\_  
Address \_\_\_\_\_

STATE OF Kansas COUNTY OF Barton, ss.  
Leonard Williamson (employee of owner) or (owner) of the above-described well, being first duly sworn on oath, says: That I have knowledge of the facts, statements, and matters herein contained and the log of the above-described well as filed and that the same are true and correct. So help me God.

(Signature) Leonard Williamson  
Box 823 - Great Bend, Kansas 67530  
(Address)

Subscribed and Sworn to before me this 1st day of February, 1973.

My commission expires 4-11-1974

Notary Public

W E L L L O G

DATE COMMENCED: January 24, 1973  
DATE COMPLETED: January 31, 1973

Icer Addis  
JOHN CAYWOOD #3  
NE/4 NW/4 SE/4  
SEC. 30-T20s,R9W  
Rice County, Kansas

|      |   |       |                      |
|------|---|-------|----------------------|
| 0    | - | 65'   | Clay & Sand          |
| 65   | - | 85'   | Sand & Shale         |
| 85   | - | 336'  | Red Bed              |
| 336  | - | 359'  | Anhydrite            |
| 359  | - | 600'  | Red Bed              |
| 600  | - | 1160' | Shale & Shells       |
| 1160 | - | 2550' | Shale & Lime Streaks |
| 2550 | - | 2800' | Lime                 |
| 2800 | - | 2804' | Shale                |
| 2804 | - | 2824' | Shale & Lime         |
| 2824 | - | 2833' | Lime                 |
| 2833 | - | 2927' | Shale                |
| 2927 | - | 2958' | Br. Lime             |
| 2958 | - | 3245' | Lime                 |
| 3245 | - | 3252' | Lime & Shale         |
| 3252 | - | 3273' | Lime, Shale, Chert   |
| 3273 | - | 3290' | Shale, Sand, Lime    |
|      |   | 3290' | RTD                  |

ELEVATION: 1725 K.B.

FORMATION DATA

|               |      |
|---------------|------|
| ANHYDRITE     | 336  |
| HEEBNER       | 2800 |
| TORONTO       | 2824 |
| DOUGLAS       | 2833 |
| BR. LIME      | 2927 |
| KANSAS CITY   | 2958 |
| BASE K. City  | 3245 |
| CONGLOMERATE  | 3252 |
| SIMPSON SHALE | 3273 |
| RTD           | 3290 |

SURFACE PIPE: Set used 8-5/8"  
28# surface pipe at 201' with  
190 sacks 60/40 pozmix, 2% Gel,  
3% C.C.

A F F I D A V I T

STATE OF KANSAS  
COUNTY OF BARTON ) ss.

Leonard Williamson, of lawful age, does state and swear that the facts and statements herein contained are true and correct to the best of his knowledge.

Leonard Williamson

Subscribed and sworn to before me this 1st day of February, 1973.

My Comm. Expires: April 11, 1974

Deborah M. Flaque  
Notary Public

RECEIVED  
STATE CORPORATION COMMISSION  
FEB 5 1973  
CONSERVATION DIVISION  
Wichita, Kansas