


Give All Information Completely  
Make Required Affidavit  
Mail or Deliver Report to:  
Conservation Division  
State Corporation Commission  
211 North  
Wichita

WELL PLUGGING RECORD

T-20 NORTH R-7W

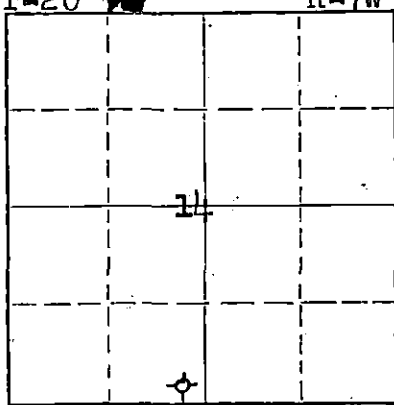

Locate well correctly on above Section Plat

Rice County. Sec. 14 Twp. 20 Rge. (E) 7 (W)  
Location as "NE/CNW/SW" or footage from lines C SE SE SW  
Lease Owner Donald T. Ingling et al  
Lease Name Davis Well No. 1  
Office Address 623 1st Nat'l Bank Bldg., Wichita 2, Kansas  
Character of Well (completed as Oil, Gas or Dry Hole) Dry Hole  
Date well completed August 5, 1958  
Application for plugging filed August 5, 1958  
Application for plugging approved August 5, 1958  
Plugging commenced August 5, 1958  
Plugging completed August 5, 1958  
Reason for abandonment of well or producing formation Dry

If a producing well is abandoned, date of last production 19  
Was permission obtained from the Conservation Division or its agents before plugging was commenced? Yes

Name of Conservation Agent who supervised plugging of this well Gilbert Toman  
Producing formation \_\_\_\_\_ Depth to top \_\_\_\_\_ Bottom \_\_\_\_\_ Total Depth of Well 3355 Feet  
Show depth and thickness of all water, oil and gas formations.

OIL, GAS OR WATER RECORDS

CASING RECORD

FORMATION	CONTENT	FROM	TO	SIZE	PUT IN	PULLED OUT
				8 5/8"	240'	None

Describe in detail the manner in which the well was plugged, indicating where the mud fluid was placed and the method or methods used in introducing it into the hole. If cement or other plugs were used, state the character of same and depth placed, from \_\_\_\_\_ feet to \_\_\_\_\_ feet for each plug set.

Gunned pits, circulated one hour and laid down one-half drill pipe, circulated one-half hour and laid down balance of drill pipe, set bridge at 240 feet to 230 feet with 15 sacks cement spotted through drill pipe then heavy mud. Set bridge 20 feet to 15 feet with 5 sacks cement and 1 sack cement in rat hole.

(If additional description is necessary, use BACK of this sheet)  
Name of Plugging Contractor Donald T. Ingling  
Address 623 1st Nat'l Bank Bldg., Wichita 2, Kansas

STATE OF KANSAS, COUNTY OF SEDGWICK, ss.  
D. T. Ingling (employee of owner) or (owner or operator) of the above-described well, being first duly sworn on oath, says: That I have knowledge of the facts, statements, and matters herein contained and the log of the above-described well as filed and that the same are true and correct. So help me God.

(Signature) D. T. Ingling  
623 1st Nat'l Bank Bldg., Wichita 2  
(Address)

SUBSCRIBED AND SWORN TO before me this 7th day of August, 1958.

My commission expires Feb. 27, 1960

**RECEIVED**  
CORPORATION COMMISSION  
Notary Public.

**PLUGGING**  
FILE SEC 14 T. 20 R. 7W  
BOOK PAGE 121 LINE 21

AUG 8 1958 8-8-58  
CONSERVATION DIVISION  
Wichita, Kansas

WELL LOG - DAVIS NO. 1

Donald T. Ingling et al, Lease Owner

Section 14-20-7W

Donald T. Ingling, Contractor

Location: C SE SE SW

Commenced: 7-26-58

County: Rice

Completed: 8-5-58

Production: Dry

Total Depth: 3355'

Elevation: 1689 RB

Casing: 8 5/8" 240' (125 sacks cement)

Figures below indicate bottom formation

30	top soil and clay	3190	lime
80	shale and sand	3270	lime
150	red rock	3276	lime
240	shale, shells and red rock	3324	shaly Conglomerate
455	shale, shells and red rock	3332	cherty Conglomerate
465	lime	3340	cherty Conglomerate
700	shale, shells and red rock	3355	shale
950	salt and shale	3355	Total Depth
1025	shale and shells		
1080	shale and shells		
1215	lime		
1415	lime, shale and sand streaks		
1615	lime		
1805	lime		
1950	lime and shale		
2130	lime and shale		
2320	lime and shale		
2465	lime and shale		
2530	lime		
2645	lime		
2745	lime		
2863	sandy lime and shells		
2869	lime		
2875	shale and lime		
2915	shale and lime		
2938	lime		
2977	lime		
3085	lime		
3145	lime		

I certify this is a true and correct copy of the above mentioned well.

STATE OF KANSAS )  
                          ) SS.  
SEDGWICK COUNTY)

PLUGGING	
FILE	SEC. 14 T. 20 R. 7W
BOOK	PAGE 121 LINE 21

*Donald T. Ingling*

Subscribed and sworn to before me, a Notary Public, in said county and state.

STATE OF KANSAS  
STATE CORPORATIONS COMMISSION

*M. E. Beach*  
Notary Public

My commission expires: Feb. 27, 1960

AUG 8 1958

CONSERVATION DIVISION  
Wichita, Kansas