

WELL PLUGGING RECORD

Give All Information Completely
Make Required Affidavit
Mail or Deliver Report to:
Conservation Division
State Corporation Commission
800 Pitting Building
Wichita, Kansas

Barton County, Sec. 31 Twp. 20 Rge. (E) 12 (W)

Location as "NE/CNW/SW" or footage from lines NE - NW - NE

Lease Owner Charles Hulme, Drilling Contractor

Lease Name Tammen Well No. 2

Office Address Great Bend, Kansas

Character of Well (completed as Oil, Gas or Dry Hole) Dry Hole

Date well completed 4-15 1956

Application for plugging filed 5-7 1956

Application for plugging approved 4-17 1956


Plugging commenced 4 - 18 1956

Plugging completed 4 - 23 1956

Reason for abandonment of well or producing formation

If a producing well is abandoned, date of last production 19

Was permission obtained from the Conservation Division or its agents before plugging was commenced? yes

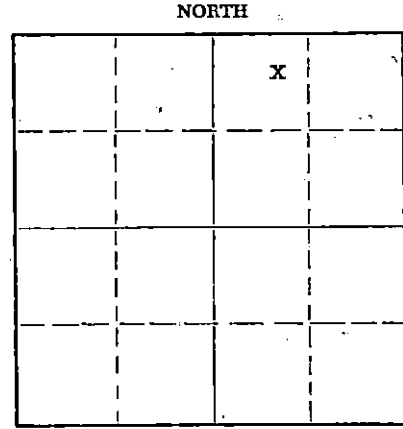

Locate well correctly on above Section Plat

Name of Conservation Agent who supervised plugging of this well R. M. Brundage

Producing formation Depth to top Bottom Total Depth of Well 3505 Feet

Show depth and thickness of all water, oil and gas formations.

OIL, GAS OR WATER RECORDS

CASING RECORD

FORMATION	CONTENT	FROM	TO	SIZE	PUT IN	PULLED OUT
		0 238	238	8 5/8		
		0	3505	5 1/2		

Describe in detail the manner in which the well was plugged, indicating where the mud fluid was placed and the method or methods used in introducing it into the hole. If cement or other plugs were used, state the character of same and depth placed, from feet to feet for each plug set.

Howco plug @ 3250 - top perforation 3241 - sanded hole to 3230' - dumped 5 sks cement - mudded hole to 240' - set 10' rock bridge - dumped 6 sks cement with bailer - bailed fluid down to plug - dumped 3 sk calseal - let set 2 hrs - bailed off fluid - dumped 14 sks cement - mudded to 35' - set bridge - dumped 10 sks cement.

STATE OF KANSAS
MAY 8 1956
CONSERVATION DIVISION
WICHITA, KANSAS

5-8-56

(If additional description is necessary, use BACK of this sheet)
Name of Plugging Contractor R & D Casing Pulling Co. License # 236
Address Box 569 Ellinwood, Kansas

STATE OF Kansas, COUNTY OF Barton, ss.
C. E. Byars (employee of owner) or (owner or operator) of the above-described

well, being first duly sworn on oath, says: That I have knowledge of the facts, statements, and matters herein contained and the log of the above-described well as filed and that the same are true and correct. So help me God.

(Signature) C. E. Byars
Box 36, Great Bend, Kansas
(Address)

SUBSCRIBED AND SWORN TO before me this 7 day of May, 1956

My commission expires October 15, 1957 Notary Public.

PLUGGING
FILE SEC 31 TWP 20 R 12W
BOOK PAGE 56 LINE 40

W E L L L O G

Company - Chas. Hulme Drilling Contractor

Sec. 31-20S-12W
Barton County, Kansas

Farm - Tammen Well No. 2

Total Depth - 3505'

Comm. - March 28, 1956 Comp. - April 15, 1956

Elevation - 1865' RB

Contractor - Chas. Hulme Drilling Contractor

Casing - 8 5/8" @ 235' w/300 sacks Posmix - 5 sacks calcium chloride
5 1/2" @ 3505' w/100 sacks cement - 1 sack calcium chloride

0	175	Sand	
175	235	Shale & Shells	
235	680	Red Bed	<u>Tops</u>
680	700	Anhydrite	
700	1540	Shale & Shells	Anhydrite 680'
1540	1830	Lime	Heebner 3084'
1830	2000	Lime & Shale	Brown Lime 3204'
2000	2180	Lime	Lansing 3219'
2180	2700	Shale & Shells	Chert Conglomerate 3439'
2700	2845	Shale & Lime	
2895	3439	Lime	
3439	3505	Chert Conglomerate	
3505		T.D.	

State of Kansas)
County of Barton) ss:

I, C. E. Byars, of Chas. Hulme Drilling Company upon oath state that the above and foregoing is a true and correct copy of the log of the Tammen #2 well.

C. E. Byars
C.E. Byars

Subscribed and sworn to before me this 17th day of April, 1956

Foy Richardson
Notary Public

My Commission Expires: October 15, 1957

RECEIVED
STATE CORPORATION COMMISSION
MAY 8 1956

PLUGGING
WELL SEC 31 T 20 R 12W
BOOK PAGE 56 LINE 40