


STATE OF KANSAS
STATE CORPORATION COMMISSION

WELL PLUGGING RECORD

Give All Information Completely
Make Required Affidavit
Mail or Deliver Report to:
Conservation Division
State Corporation Commission
800 Bittling Building
Wichita, Kansas

Barton County, Sec. 30 Twp. 20 Rge. 12 (E) (W)
Location as "NE/CNW/SW" or footage from lines SE SE NW/4
Lease Owner S. A. Murphy
Lease Name Welsh Well No. 1
Office Address 701 Brown Bldg., Wichita 2, Kansas
Character of Well (completed as Oil, Gas or Dry Hole) Dry hole
Date well completed 4-8-55 19
Application for plugging filed 4-8-55 19
Application for plugging approved 4-8-55 19
Plugging commenced 4-9-55 19
Plugging completed 4-9-55 19
Reason for abandonment of well or producing formation _____

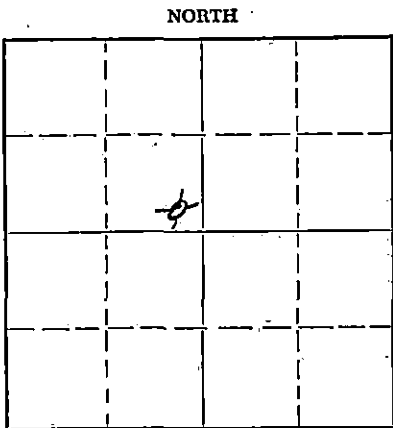

Locate well correctly on above
Section Plat

If a producing well is abandoned, date of last production _____ 19____
Was permission obtained from the Conservation Division or its agents before plugging was commenced? yes

Name of Conservation Agent who supervised plugging of this well Warren H. Horner
Producing formation _____ Depth to top _____ Bottom _____ Total Depth of Well 3550 Feet
Show depth and thickness of all water, oil and gas formations.

OIL, GAS OR WATER RECORDS

CASING RECORD

FORMATION	CONTENT	FROM	TO	SIZE	PUT IN	PULLED OUT
		0	243	8 5/8"	247	none

Describe in detail the manner in which the well was plugged, indicating where the mud fluid was placed and the method or methods used in introducing it into the hole. If cement or other plugs were used, state the character of same and depth placed, from _____ feet to _____ feet for each plug set.

Mudded hole to 240 ft. - set plug w/15 sx cement 1/3 sx hulls
Mudded to 35 ft - set plug w/ 10 sx cement 1/3 sx hulls

(If additional description is necessary, use BACK of this sheet)

Name of Plugging Contractor Virginia Drilling Co Inc.
Address 701 Brown Bldg., Wichita 2, Kansas

STATE OF Kansas COUNTY OF Sedgewick, ss.
Murlee Hawkins (employee of owner) or (owner or operator) of the above-described

well, being first duly sworn on oath, says: That I have knowledge of the facts, statements, and matters herein contained and the log of the above-described well as filed and that the same are true and correct. So help me God.

(Signature) Murlee Hawkins
701 Brown Bldg., Wichita 2, Kansas
(Address)

SUBSCRIBED AND SWORN TO before me this 12th day of April, 1955

My commission expires March 15, 1958

Inez M. Underwood
Notary Public.

24-7368-8 3-53-20M

RECEIVED
STATE CORPORATION COMMISSION
APR 14 1955
CONSERVATION DIVISION
Wichita, Kansas

PLUGGING
FILE SEC 30 T 20 R 12 W
BOOK PAGE 10 LINE 30

4-14-55

WELSH #1 - SE SE NW/4 Section 30-20-12 Barton County, Kansas
 Company - S. A. Murphy
 Contractor - Virginia Drilling Co. Inc.
 Commenced - March 29, 1955
 Completed - April 8, 1955
 Elevation - 1860 DF
 Total Depth - 3550. 8 5/8" set at 243 ft.

FORMATION	DEPTH	TOPS:
Sand-clay-shale	0-243	
Shale	243-690	
Anhydrite	690-705	
Shale	705-760	
Shale-shells	760-1195	
Shale-sand-shells	1195-1550	
Lime	1550-1985	3087 - Esbner
Lime-shale	1985-2220	3210 - Brown lime
Shale	2220-2275	3226 - Lansing
Shale-shells	2275-2550	3464 - Conglomerate (chert)
Shale-lime	2550-2845	3470 - Viola (chert)
Brkn lime	2845-2940	3500 - Altered Simpson shale
Lime	2940-3080	
Shale-lime	3080-3190	
Lime	3190-3450	3536 - Arbuckle.
Cherty lime	3450-3500	
Conglomerate	3500-3515	
Lime	3515-3550 T D	

Murlee Hawkins
 Murlee Hawkins

Subscribed and sworn to before me, a Notary Public, this 12th day of April, 1955.

Irene M. Underwood
 Notary Public

My commission expires: March 15, 1958.

PLUGGING
 PER 30 720 12u
 DAK PAGE 112 LINE 3e