


Give All Information Completely
Make Required Affidavit
Mail or Deliver Report to:
Conservation Division
State Corporation Commission
211 No. Broadway
Wichita, Kansas

WELL PLUGGING RECORD

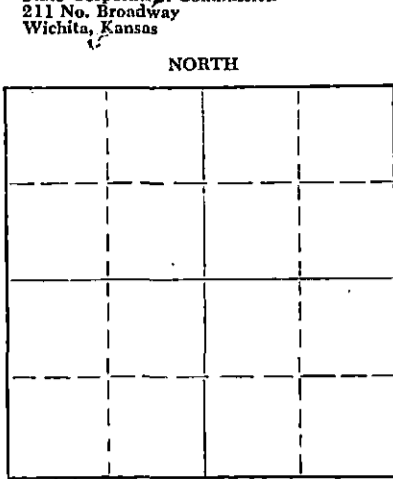

Locate well correctly on above
Section Plat

Barton County, Sec. 30 Twp. 20 Rge. 12 (E) W (W)
Location as "NE/CNW/SW" or footage from lines. NE SE SW
Lease Owner Apex Supply Co.
Lease Name Krone #1 Well No. _____
Office Address Great Bend, Kansas
Character of Well (completed as Oil, Gas or Dry Hole) _____
Date well completed _____ 19____
Application for plugging filed _____ 19____
Application for plugging approved _____ 19____
Plugging commenced 7-14-59 19____
Plugging completed 7-16-59 19____
Reason for abandonment of well or producing formation _____

If a producing well is abandoned, date of last production _____ 19____
Was permission obtained from the Conservation Division or its agents before plugging was commenced? yes

Name of Conservation Agent who supervised plugging of this well Don T.uan
Producing formation _____ Depth to top _____ Bottom _____ Total Depth of Well 3555 Feet
Show depth and thickness of all water, oil and gas formations.

OIL, GAS OR WATER RECORDS

CASING RECORD

FORMATION	CONTENT	FROM	TO	SIZE	PUT IN	PULLED OUT
				8-5/8"	225'	none
				5-1/2"	3554'	2909'

Describe in detail the manner in which the well was plugged, indicating where the mud fluid was placed and the method or methods used in introducing it into the hole. If cement or other plugs were used, state the character of same and depth placed, from _____ feet to _____ feet for each plug set.

Checked the hole to 3532' and found it open.
Filled w/sand to 3490' and dumped 5 sacks of cement with bailer. Pulled 5 1/2" casing.
Cleared hole and bailed hole to 225', set 10' rock bridge and dumped 20 sacks of cement.
Mudded the hole to 40', set 10' rock bridge and ran 10 sacks of cement to base of cellar.

8-10-59

PLUGGING COMPLETED

RECEIVED
STATE CORPORATION COMMISSION
AUG 10 1959
CONSERVATION DIVISION
Wichita, Kansas

(If additional description is necessary, use BACK of this sheet)
Name of Plugging Contractor Knight Casing Pulling Co.
Address Chase, Kansas

STATE OF KANSAS, COUNTY OF RICE, ss.
I, Noel J. Knight (employee of owner) or ~~owner~~ of the above-described well, being first duly sworn on oath, says: That I have knowledge of the facts, statements, and matters herein contained and the log of the above-described well as filed and that the same are true and correct. So help me God.

(Signature) [Signature]
Chase, Kansas
(Address)

SUBSCRIBED AND SWORN TO before me this 5th day of August, 1959

My commission expires 9-27-62

[Signature]
Notary Public.

PLUGGING
FILE SEC. 30 T. 20 R. 12
BOOK PAGE 5 / LINE 21

WELL LOG BUREAU—KANSAS GEOLOGICAL SOCIETY
503 East Murdock, Wichita, Kansas


Company. SHELLEY-MILLER DRILLING, INC.
Farm. Krone No. 1

SEC. 30 T. 20 R. 12W
NE SE SW

Total Depth. 3555.
Comm. 8-29-55 Comp. 9-9-55
Shot or Treated.

County Barton
KANSAS

Contractor. Shelley-Miller Drilling, Inc.
Issued. 12-31-55

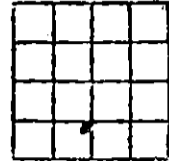

CASING:

8 5/8 @ 224' w/ 175 sx cmt.
5 1/2 @ 3554' w/ 100 sx cmt.

Elevation. 1862 RB

Production. 9 BOPD

Figures indicate Bottom of Formations.

sand	134
shale & shells	224
red bed	673
anhydrite	695
shale & shells	1420
lime & shale	2440
shale & shells	2595
lime & shale	2860
lime	3555
Total Depth	

TOPS:

Heebner	3089
Brown lime	3212
Lansing	3228
Conglomerate	3466
Arbuckle	3471

R. B. Meas.

RECEIVED
STATE CORPORATION COMMISSION

MAR 16 1967

CONSERVATION DIVISION
Wichita, Kansas