


STATE OF KANSAS
STATE CORPORATION COMMISSION

Form CP-4

WELL PLUGGING RECORD

Give All Information Completely
Make Required Affidavit
Mail or Deliver Report to:
Conservation Division
State Corporation Commission
212 No. Market
Wichita, Kansas

NORTH

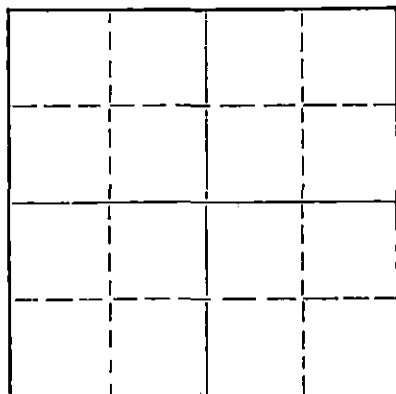

Locate well correctly on above
Section Plat

Location as "NE/CNW/SW" or footage from lines Barton County, Sec. 30 Twp. 20 Rge. 12 (E) (W)x
SW NE NE
Lease Owner E. K. Edmiston
Lease Name Flanders Well No. #11
Office Address 425 First National Bank Bldg. Wichita, Kansas
Character of Well (completed as Oil, Gas or Dry Hole) _____
Date well completed _____ 19____
Application for plugging filed 11-30-66 19____
Application for plugging approved _____ 19____
Plugging commenced 12-1-66 19____
Plugging completed 12-8-66 19____
Reason for abandonment of well or producing formation _____

If a producing well is abandoned, date of last production _____ 19____
Was permission obtained from the Conservation Division or its agents before plugging was commenced? _____

Name of Conservation Agent who supervised plugging of this well Donald Truan
Producing formation _____ Depth to top _____ Bottom _____ Total Depth of Well 3542' Feet
Show depth and thickness of all water, oil and gas formations.

OIL, GAS OR WATER RECORDS

CASING RECORD

FORMATION	CONTENT	FROM	TO	SIZE	PUT IN	PULLED OUT

Describe in detail the manner in which the well was plugged, indicating where the mud fluid was placed and the method or methods used in introducing it into the hole. If cement or other plugs were used, state the character of same and depth placed, from _____ feet to _____ feet for each plug set.

Made bottom hole plug back with sand to 3260'. Mixed and ran 3 sacks of cement thru dump bailer.
Mudded hole to 265', set 15' rock bridge. Mixed and ran 2 sacks cement and 1 sack of Calseal for flash plug. Squeezed hole with 3 1/2 yards of ready mix.

RECEIVED
STATE CORPORATION COMMISSION

DEC 12 1966 12-12-66

CONSERVATION DIVISION
WICHITA, KANSAS

(If additional description is necessary, use BACK of this sheet)
Name of Plugging Contractor Southwest Casing Pulling Co., Inc.
Address Box 364, Great Bend, Kansas

STATE OF Kansas COUNTY OF Barton, ss.
Southwest Casing Pulling Co., Inc. (employee of owner) or (owner or operator) of the above-described well, being first duly sworn on oath, says: That I have knowledge of the facts, statements, and matters herein contained and the log of the above-described well as filed and that the same are true and correct. So help me God.

(Signature) W. C. Spencer Sec.
Box 364, Great Bend, Kansas
(Address)

SUBSCRIBED AND SWORN TO before me this 10 day of December, 1966

My commission expires 24 October 1968
Sidney D. Miller
Notary Public.

DRILLER'S LOG

Company: E. K. Edmiston
425 First National Bank Building
Wichita, Kansas 67202

Rotary Drilling Commenced: October 12, 1965

Rotary Drilling Completed: October 24, 1965

Well Name: FLANDERS No. 4
SW NE NE 30-20S-12W
Barton County, Kansas

Contractor: E. K. Edmiston Drilling Co., Inc.
425 First National Bank Building
Wichita, Kansas 67202

Casing Record: 8-5/8" at 265' with 250 sacks cement
4-1/2" at 3542' with 125 sacks cement

LOG

Measurements from top of rotary bushing

Sand and Shale	0 - 265
Shale	664
Anhydrite	676
Shale	988
Shale and Shells	1480
Shale and Sandy Lime streaks	1530
Lime	1625
Lime and Shale	2040
Shale	2365
Shale and Lime	2940
Lime and Shale	3131
Shale and Lime	3248
Lime and Shale	3335
Lime	3431
Lime and Shale	3460
Lime	3492
Lime and Shale	3502
Lime	3510
Arbuckle	3542 RTD

RECEIVED
STATE CORPORATION COMMISSION

JAN 30 1967

CONSERVATION DIVISION
Wichita, Kansas

The undersigned, E. K. Edmiston, President of E. K. Edmiston Drilling Co., Inc., hereby certifies on behalf of said company, that the above log is a true and correct log of the formations encountered in drilling the above well, as reflected by the daily drilling reports.

E. K. EDMISTON-DRILLING CO., INC.

By 
E. K. Edmiston, President


STATE OF KANSAS,

SS:

SEDGWICK COUNTY,

BE IT REMEMBERED that on this 1st day of November, 1965, before me, the undersigned, a notary public in and for the county and state aforesaid, came E. K. Edmiston, known to me to be the same person who executed the foregoing instrument as President and on behalf of E. K. Edmiston Drilling Co., Inc., and he duly acknowledged the execution of the same.

IN WITNESS WHEREOF, I have hereunto set my hand and official seal on the day and year last above written.

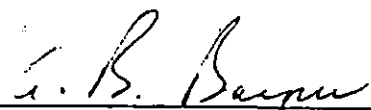
A. B. Barga, Notary Public

My commission expires
August 25, 1968