


STATE OF KANSAS
STATE CORPORATION COMMISSION

Give All Information Completely
Make Required Affidavit
Mail or Deliver Report to:
Conservation Division
State Corporation Commission
211 No. Broadway
Wichita, Kansas

WELL PLUGGING RECORD

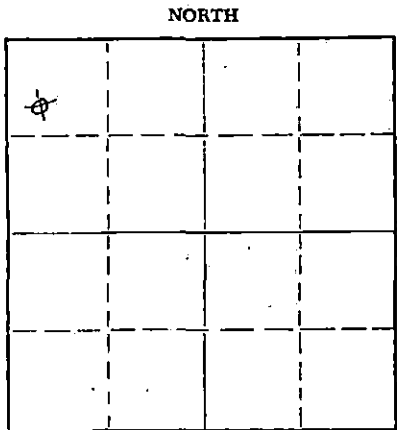

Locate well correctly on above
Section Plat

Barton County: Sec. 31 Twp. 20n Rge. 12w (E) (W)

Location as "NE/CNW/SW" or footage from lines SW NW NW
Lease Owner Virginia Drilling Co Inc.
Lease Name Spacil Well No. 3
Office Address 712 Brown Bldg. Wichita, Kans
Character of Well (completed as Oil, Gas or Dry Hole) dry hole
Date well completed July 14, 1965 19
Application for plugging filed " 19
Application for plugging approved " 19
Plugging commenced " 19
Plugging completed " 19
Reason for abandonment of well or producing formation _____

If a producing well is abandoned, date of last production _____ 19
Was permission obtained from the Conservation Division or its agents before plugging was commenced? yes

Name of Conservation Agent who supervised plugging of this well ~~XXXXXXXXXX~~ Donald Bruan-Russell, Kansas
Producing formation _____ Depth to top _____ Bottom _____ Total Depth of Well 3520 Feet
Show depth and thickness of all water, oil and gas formations.

OIL, GAS OR WATER RECORDS

CASING RECORD

FORMATION	CONTENT	FROM	TO	SIZE	PUT IN	PULLED OUT
		0	263	8.5/8	263	none

Describe in detail the manner in which the well was plugged, indicating where the mud fluid was placed and the method or methods used in introducing it into the hole. If cement or other plugs were used, state the character of same and depth placed, from _____ feet to _____ feet for each plug set.

Mudded to 260' .. set plug w/ 1/4 sx hulls 25 sx cement
Mudded to 40' .. set plug w/ 1/4 sx hulls and 10 sx cement

7-30-65

RECEIVED
STATE CORPORATION COMMISSION

JUL 30 1965

CONSERVATION DIVISION
Wichita, Kansas

(If additional description is necessary, use BACK of this sheet)
Name of Plugging Contractor Virginia Drilling Co., Inc.
Address 712 Brown Bldg. Wichita, Kans 67202

STATE OF Kansas COUNTY OF Sedgwick, ss.
S. A. Murphy (employee of owner) or (owner or operator) of the above-described well, being first duly sworn on oath, says: That I have knowledge of the facts, statements, and matters herein contained and the log of the above-described well as filed and that the same are true and correct. So help me God.

(Signature) S. A. Murphy
712 Brown Bldg. Wichita, Kansas
(Address)

SUBSCRIBED AND SWORN TO before me this 29th day of July, 1965
Feb 5, 1969
My commission expires _____
Conrad Hawk
Notary Public.

SPACIL # 3 - SW NW NW Section 31-20S-12W
 Company - Virginia Drilling Co., Inc.
 Contractor - Virginia Drilling Co., Inc.
 Commenced - July 7, 1965
 Completed - July 14, 1965
 Elevation - 1871 K.B.
 Total Depth - 3520

8 5/8" @ 263 w/ 250 sx Cem.
 Dry & Abandoned

FORMATION	DEPTH	TOPS:	
Sand & Shale	0 - 160		
Shale	160 - 263		
Red Bed & Shale	263 - 600	Anhydrite	700 -1171
Red Rock	600 - 700	Heebner Shale	3105 -1234
Anhydrite	700 - 725	Toronto Lime	3122 -1251
Shale & Shells	725 - 1500	Douglas Shale	3138 -1267
Lime & Shale	1500 - 1620	Iatan Lime	3226 -1355
Lime	1620 - 1745	Lansing	3242 -1371
Lime & Shale	1745 - 2300	Base Kansas City	3461 -1590
Shale & Shells	2300 - 2655	Conglomerate	3484 -1613
Lime & Shale	2655 - 3510	Weathered Arbuckle	3495 -1624
Lime	3510 - 3520	Arbuckle	3510 -1639
		Rotary Total Depth	3520 -1649

S. A. Murphy
 S. A. Murphy

Subscribed and sworn to before me, a Notary Public, this
 21st day of July, 1965.

Murder Hawley
 Notary Public

My commission expires: Febr. 5, 1969.