


Give All Information Completely
Make Required Affidavit
Mail or Deliver Report to:
Conservation Division
State Corporation Commission
211 N. Broadway
Wichita, Kansas

WELL PLUGGING RECORD

NORTH

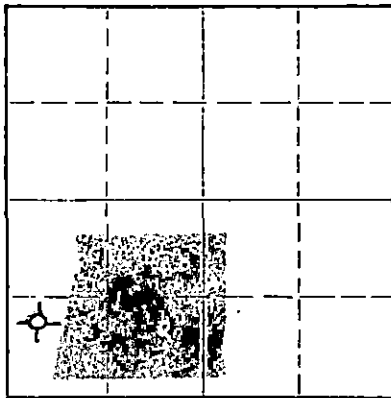

Locate well correctly on above
Section Plat

Barton County, Sec. 21 Twp. 20 Rge. 12 (E) W (W)
Location as "NE/CNWxSWx" or footage from lines NW SW SW
Lease Owner C-G Drilling Co.
Lease Name Hulme Well No. 3
Office Address 107 Rule Building, Wichita, Kansas
Character of Well (completed as Oil, Gas or Dry Hole) Dry Hole
Date well completed Sept. 13, 1964
Application for plugging filed Sept. 13, 1964
Application for plugging approved Sept. 13, 1964
Plugging commenced Sept. 13, 1964
Plugging completed Sept. 13, 1964
Reason for abandonment of well or producing formation Too low structually

If a producing well is abandoned, date of last production _____ 19____
Was permission obtained from the Conservation Division or its agents before plugging was commenced? Yes

Name of Conservation Agent who supervised plugging of this well Donald Truan
Producing formation _____ Depth to top _____ Bottom _____ Total Depth of Well 3500' Feet
Show depth and thickness of all water, oil and gas formations.

OIL, GAS OR WATER RECORDS

CASING RECORD

FORMATION	CONTENT	FROM	TO	SIZE	PUT IN	PULLED OUT
				8-5/8"	278'	None

Describe in detail the manner in which the well was plugged, indicating where the mud fluid was placed and the method or methods used in introducing it into the hole. If cement or other plugs were used, state the character of same and depth placed, from _____ feet to _____ feet for each plug set.

Filled hole with heavy mud to 260'. Set plug. Put in 25 sacks cement. Filled with heavy mud to 40'. Set plug. Filled to top with 10 sacks cement.

RECEIVED
STATE CORPORATION COMMISSION

SEP 24 1964 9-24-64


CONSERVATION DIVISION
Wichita, Kansas

(If additional description is necessary, use BACK of this sheet)
Name of Plugging Contractor C-G Drilling Co.
Address 107 Rule Building, Wichita, Kansas 67202

STATE OF Kansas, COUNTY OF Sedgwick, ss.
G. F. Galloway (employee of owner) or (owner or operator) of the above-described well, being first duly sworn on oath, says: That I have knowledge of the facts, statements, and matters herein contained and the log of the above-described well as filed and that the same are true and correct. So help me God.

(Signature) G. F. Galloway
107 Rule Building
(Address)

Subscribed and sworn to before me this 15th day of September, 1964

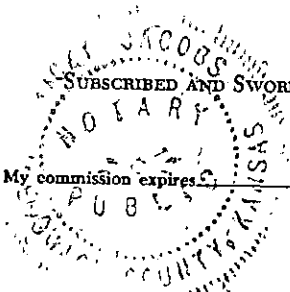

Vicky Jacobs
Notary Public.

WELL LOG

OPERATOR: C-G DRILLING CO.WELL NAME: HULME #3 LOCATION: NW SW SW Sec. 21-20-12WCOUNTY: BARTON STATE: KANSASWELL COMMENCED: SEPT. 3, 1964 WELL COMPLETED: SEPT. 13, 1964ELEVATION: 1854' K.B. TOTAL DEPTH: 3500'PRODUCTION: Dry & Abandoned RIG NO: 2CASING - 8-5/8": Set 278' (8 jts.) 20# 8-5/8" Surface casing

5-1/2": _____

All Measurements taken from the top of rotary bushing.

FROM	TO	FORMATION	DEVIATION FROM VERTICAL	REMARKS:
0	235	Sand & Shale		
235	635	Red Bed	500' - 0°	
635	670	Anhydrite		
670	980	Shale & Shells		
980	1565	Shale	1000' - 1/4°	
1565	2883	Lime & Shale	1500' - 1/4°	
2883	3500	Lime	2500' - 1/4°	DST 3189-3220 DST 3342-3360 DST 3445-3454 DST 3451-3500

RECEIVED
STATE CORPORATION COMMISSION

SEP 24 1964

CONSERVATION DIVISION
Wichita, KansasSTATE OF KANSAS
COUNTY OF SEDGWICK) SS:

The undersigned hereby certifies that to the best of his knowledge and belief, the above facts are true and correct.

C-G DRILLING CO.

By G. F. Galloway

G. F. GALLOWAY

SUBSCRIBED AND SWORN TO, BEFORE ME, This 15th day of September, 1964

My comm. exp: May 20, 1967

Vicky Jacobs
Vicky Jacobs - Notary Public