


Give All Information Completely  
Make Required Affidavit  
Mail or Deliver Report to:  
Conservation Division  
State Corporation Commission  
212 North Market, Insurance Bldg.  
Wichita, Kansas

WELL PLUGGING RECORD

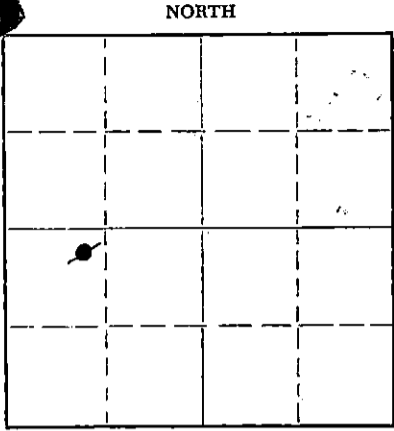

Locate well correctly on above Section Plat

Barton County. Sec. 21 Twp. 20S Rge. 12 (E) W (W)  
Location as "NE/CNW/SW" or footage from lines NE NW SW  
Lease Owner C-G Drilling Co.  
Lease Name Hulme Well No. 2  
Office Address 107 Rule Building, Wichita 2, Kansas  
Character of Well (completed as Oil, Gas or Dry Hole) Dry Hole  
Date well completed December 10 19 61  
Application for plugging filed December 10 19 61  
Application for plugging approved December 10 19 61  
Plugging commenced December 10 19 61  
Plugging completed December 10 19 61  
Reason for abandonment of well or producing formation Too low structurally

If a producing well is abandoned, date of last production \_\_\_\_\_ 19\_\_\_\_  
Was permission obtained from the Conservation Division or its agents before plugging was commenced? Yes

Name of Conservation Agent who supervised plugging of this well Eldon Petty, Hays, Kansas  
Producing formation \_\_\_\_\_ Depth to top \_\_\_\_\_ Bottom \_\_\_\_\_ Total Depth of Well 3497 Feet  
Show depth and thickness of all water, oil and gas formations.

OIL, GAS OR WATER RECORDS

CASING RECORD

FORMATION	CONTENT	FROM	TO	SIZE	PUT IN	PULLED OUT
				8-5/8"	304.51	None

Describe in detail the manner in which the well was plugged, indicating where the mud fluid was placed and the method or methods used in introducing it into the hole. If cement or other plugs were used, state the character of same and depth placed, from \_\_\_\_\_ feet to \_\_\_\_\_ feet for each plug set.

Filled hole with heavy mud to 200'.  
Set plug. Put in 20 sacks cement.  
Filled to 180'. Set plug. Put in  
1/2 sack hulls and 20 sacks cement.  
Filled with heavy mud up to 70'.  
Set plug. Filled to top with 1/2  
sack hulls and 10 sacks cement.

12-18-61

RECEIVED  
STATE CORPORATION COMMISSION

DEC 18 1961

CONSERVATION DIVISION  
Wichita, Kansas

(If additional description is necessary, use BACK of this sheet)

Name of Plugging Contractor C-G Drilling Co.  
Address 107 Rule Building, Wichita 2, Kansas


STATE OF KANSAS, COUNTY OF SEDGWICK, ss.  
G. F. Galloway (employee of owner) or (owner or operator) of the above-described well, being first duly sworn on oath, says: That I have knowledge of the facts, statements, and matters herein contained and the log of the above-described well as filed and that the same are true and correct. So help me God.

(Signature) G. F. Galloway  
107 Rule Building  
(Address)

SUBSCRIBED AND SWORN to before me this 15th day of December, 1961

My Commission expires May 20, 1963

Vicky Jacobs  
Notary Public.

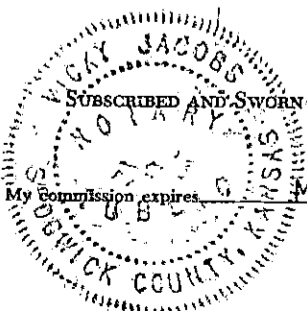

15.009.05220.0000

W E L L L O G

OPERATOR C-G Drilling Co.

SEC. 21-20S-12W

WELL NAME Hulme #2

LOC. NE NW SW

TOTAL DEPTH 3497'

COUNTY Barton

COMM. November 29, 1961 COMP. December 10, 1961

STATE Kansas

RIG NO. 2

ELEVATION 1838' K.B.

CASING: Ran 304.51' (11 jts.) 8-5/8" OD Surface Casing.

PRODUCTION: D & A

All measurements taken from the top of rotary bushing.

FROM	TO	FORMATION	DEVIATION FROM VERTICAL	REMARKS
0	240	Sand & Shale		
240	628	Red Bud		
628	660	Anhydrite		
660	740	Shale & Shells		
740	1330	Shale & Shell		
1330	1480	Shale & Shells		
1480	1990	Lime & Shale		
1990	2845	Shale & Lime	0° - 2500	
2845	3420	Lime	0° - 2750	
3420	3497	Arbuckle	0° - 3000	JST 3428-3442'
			0° - 3250	DST 3436-3452'
				DST 3452-3469'
				DST 3469-3497'

RECEIVED  
STATE CORPORATION COMMISSION

DEC 27 1961

CONSERVATION DIVISION  
Wichita, Kansas

STATE OF KANSAS )  
                          ) S.  
COUNTY OF SEDGWICK )

The undersigned hereby certifies that to the best of his knowledge and belief, the above facts are true and correct.

C-G DRILLING CO.

By G. F. Galloway  
G. F. Galloway

SUBSCRIBED AND SWORN TO BEFORE ME, THIS 15th day of December, 1961

Vicky Jacobs  
Vicky Jacobs, Notary Public

