


STATE OF KANSAS
STATE CORPORATION COMMISSION

WELL PLUGGING RECORD

Give All Information Completely
Make Required Affidavit
Mail or Deliver Report to:
Conservation Division
State Corporation Commission
211 No. Broadway
Wichita, Kansas

NORTH

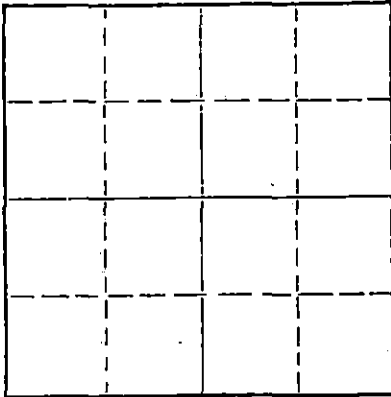

Locate well correctly on above
Section Plat

Barton County. Sec. 21 Twp. 20 Rge. 12 (E) (W)

Location as "NE/CNW/SW" or footage from lines SE NE NE

Lease Owner Chas Hulme Drilling Contractor

Lease Name Gelwick

Well No. 9

Office Address P. O. Box 836 Great Bend, Kansas

Character of Well (completed as Oil, Gas or Dry Hole)

Date well completed 19

Application for plugging filed 4-2-64 19

Application for plugging approved 4-3-64 19

Plugging commenced 4-5-64 19

Plugging completed 4-8-64 19

Reason for abandonment of well or producing formation

Dry

If a producing well is abandoned, date of last production 19

Was permission obtained from the Conservation Division or its agents before plugging was commenced? Yes

Name of Conservation Agent who supervised plugging of this well Donald Trian

Producing formation Depth to top Bottom Total Depth of Well 3150 Feet

Show depth and thickness of all water, oil and gas formations.

OIL, GAS OR WATER RECORDS

CASING RECORD

FORMATION	CONTENT	FROM	TO	SIZE	PUT IN	PULLED OUT
				8 5/8	201	None
				4 1/2	None	2726

Describe in detail the manner in which the well was plugged, indicating where the mud fluid was placed and the method or methods used in introducing it into the hole. If cement or other plugs were used, state the character of same and depth placed, from feet to feet for each plug set.

Moved unit on location. Rigging up.

Finished rigging up unit. Cemented bottom with 4 sacks. Shot pipe at 2720'. Worked pipe.

Working pipe. Pulling pipe.

Removed casing head. Squeezed well with 10 sacks jell mud and 80 sacks of cement.

RECEIVED
STATE CORPORATION COMMISSION

4-13-64
APR 13 1964

CONSERVATION DIVISION
Wichita, Kansas

(If additional description is necessary, use BACK of this sheet)

Name of Plugging Contractor: Forbes Casing Pulling, Inc.

Address P. O. Box 221 Great Bend, Kansas

STATE OF Kansas, COUNTY OF Barton, ss.

J. O. Forbes (employee of owner) or (owner or operator) of the above-described well, being first duly sworn on oath, says: That I have knowledge of the facts, statements, and matters herein contained and the log of the above-described well as filed and that the same are true and correct. So help me God.

(Signature)

J. O. Forbes
P. O. Box 221 Great Bend, Kansas
(Address)

SUBSCRIBED AND SWORN TO before me this 9 day of April, 1964

My commission expires May 27, 1964

Charles Osh
Notary Public.

CHAS. HULME DRILLING CONTRACTOR

P. O. Box 836

GREAT BEND, KANSAS

WELL LOG

GELWICKS #9

SE NE NE

21-20-12

DARTON COUNTY, KANSAS

			ELEVATION	
0	201	SAND		1829' D. F.
201	435	RED BED SHALE		1832' R. B.
435	605	SHALE & RED BED		
605	628	ANHYDRITE	618'	
638	1150	SHALE & SHELLS	HEEHER	3012' - 1180'
1150	2365	SHALE & LIME	BROWN LIME	3134' - 1302'
2365	2530	SHALE SHELLS	KANSAS CITY	3148' - 1316'
2530	2700	SHALE & LIME	CONGLOMERATE	3377' - 1545'
2700	3019	LIME	ARBUCKLE	3386' - 3400'
3019	3150	SHALE & LIME		
3150	3430	LIME		
3430		ROTARY T.D.		

RECEIVED
STATE CORPORATION COMMISSION

APR 22 1963

CONSERVATION DIVISION
Wichita, Kansas

STATE OF KANSAS
COUNTY OF BARTON 55

C. E. BYARS, PARTNER OF CHAS. HULME DRILLING CONTRACTOR BEING FIRST DULY SWORN ON OATH SAYS: THAT I HAVE KNOWLEDGE OF THE FACTS, STATEMENTS, AND MATTERS HEREIN CONTAINED AND THE LOG OF THE ABOVE DESCRIBED WELL AS FILED AND THAT THE SAME ARE TRUE AND CORRECT.

C. E. Byars
C. E. BYARS

SUBSCRIBED AND SWORN BEFORE ME THIS 11th DAY OF December, 1963.

[Signature]
NOTARY PUBLIC BARTON COUNTY

MY COMMISSION EXPIRES: 4-24-67