


STATE OF KANSAS
STATE CORPORATION COMMISSION

Give All Information Completely
Make Required Affidavit
Mail or Deliver Report to:
Conservation Division
State Corporation Commission
211 No. Broadway
Wichita, Kansas

WELL PLUGGING RECORD

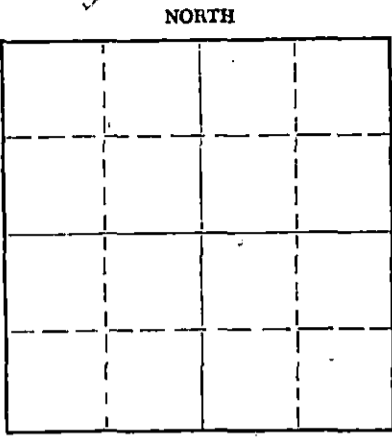

Locate well correctly on above
Section Plat

Barton County, Sec. 21 Twp. 20S Rge. 13 (E) (W) X
Location as "NE/CNW/SW" or footage from lines SW SW SE
Lease Owner Forbes Casing Pulling, Inc.
Lease Name Sandrock Well No. 1
Office Address P. O. Box 221 Great Bend, Kansas
Character of Well (completed as Oil, Gas or Dry Hole) _____
Date well completed _____ 19____
Application for plugging filed 9-26-63 19____
Application for plugging approved 9-27-63 19____
Plugging commenced 9-30-63 19____
Plugging completed 10-1-63 19____
Reason for abandonment of well or producing formation Dry

If a producing well is abandoned, date of last production _____ 19____
Was permission obtained from the Conservation Division or its agents before plugging was commenced? Yes

Name of Conservation Agent who supervised plugging of this well Truan
Producing formation _____ Depth to top _____ Bottom _____ Total Depth of Well 3601 Feet
Show depth and thickness of all water, oil and gas formations.

OIL, GAS OR WATER RECORDS

CASING RECORD

FORMATION	CONTENT	FROM	TO	SIZE	PUT IN	PULLED OUT
				8 5/8	252	None
				5 1/2	None	2763

Describe in detail the manner in which the well was plugged, indicating where the mud fluid was placed and the method or methods used in introducing it into the hole. If cement or other plugs were used, state the character of same and depth placed, from _____ feet to _____ feet for each plug set.

Cleaning cellar. Working pipe.
Sanded to 3530'. Dumped 5 sacks of cement. Shot pipe at 2750'.
Working pipe.
Pulling pipe.
Pulling pipe.
Bailing. Pushed plug to 250'. Build rock bridge. Dumped 10 sacks of cement.
Bailing. Dumped 15 sacks of cement. Build rock bridge at 40'. Capped well with 10 sacks of cement.

RECEIVED
STATE CORPORATION COMMISSION

OCT 8 1963

CONSERVATION DIVISION
Wichita, Kansas

(If additional description is necessary, use BACK of this sheet)
Name of Plugging Contractor Forbes Casing Pulling, Inc.
Address P. O. Box 221 Great Bend, Kansas

STATE OF Kansas, COUNTY OF Barton, ss.
J. O. Forbes (employee of owner) or (owner or operator) of the above-described well, being first duly sworn on oath, says: That I have knowledge of the facts, statements, and matters herein contained and the log of the above-described well as filed and that the same are true and correct. So help me God.

(Signature) J. O. Forbes
P. O. Box 221 Great Bend, Kansas
(Address)

SUBSCRIBED AND SWORN to before me this 7 day of October, 19 63

My commission expires May 27, 1964

Notary Public.

WELL LOG

DATE COMMENCED: March 20, 1951
 DATE COMPLETED: April 5, 1951

ADKENS DRILLING COMPANY, INC.
 SANDROCK NO. 1
 SW SW SE
 SECTION 21- 20S-13W
 BARTON COUNTY, KANSAS

0	---	102'	Clay
102	---	153'	Sand
153	---	299'	Shale
299	---	743'	Sand & Shale
743	---	765'	Anhydrite
765	---	818'	Shells & Shale
818	---	1572'	Shale
1572	---	2373'	Lime & Shale
2373	---	2662'	Lime Shale Shells
2662	---	2924'	Shale
2924	---	3139'	Lime & Shale
3139	---	3143'	Shale
3143	---	3164'	Lime & Shale
3164	---	3179'	Lime TORONTO
3179	---	3260'	Shale DOUGLAS
3260	---	3271'	Shale & Lime
3271	---	3500'	Shale
3500	---	3526'	Conglomerate Shale
3526	---	3543'	Dolomite TD

FIELD: WILDCAT
 ELEVATION: 1888 K.B.

CASING RECORD

8 5/8" Casing at 252' with 140
 sacks of cement.

5 1/2" Casing at 3543' with 150
 sacks of cement.

Cable Tool TD 3601'

RECEIVED
 STATE CORPORATION COMMISSION

SEP 27 1963

CONSERVATION DIVISION
 Wichita, Kansas