


WELL PLUGGING RECORD

Give All Information Completely
Make Required Affidavit
Mail or Deliver Report to:
Conservation Division
State Corporation Commission
212 North Market, Insurance Bldg.
Wichita, Kansas

NORTH

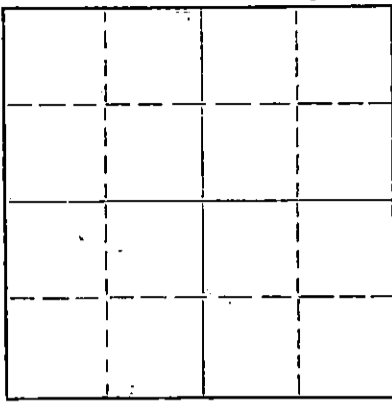

Locate well correctly on above
Section Plat

Barton County. Sec. 21 Twp. 20 Rge. (E) 14 (W)
Location as "NE/CNW/SW" or footage from lines NW SE NE
Lease Owner Musgrove Petroleum Corporation
Lease Name ADAMS Well No. 2
Office Address 801 Union Center, Wichita, Kansas
Character of Well (completed as Oil, Gas or Dry Hole) Dry hole
Date well completed July 2, 1959
Application for plugging filed verbally - July 2, 1959
Application for plugging approved verbally - July 2, 1959
Plugging commenced July 2, 1959
Plugging completed July 2, 1959
Reason for abandonment of well or producing formation Dry

If a producing well is abandoned, date of last production _____ 19____
Was permission obtained from the Conservation Division or its agents before plugging was commenced? verbally - yes.

Name of Conservation Agent who supervised plugging of this well _____
Producing formation: _____ Depth to top _____ Bottom _____ Total Depth of Well 3560 Feet
Show depth and thickness of all water, oil and gas formations.

OIL, GAS OR WATER RECORDS

CASING RECORD

FORMATION	CONTENT	FROM	TO	SIZE	PUT IN	PULLED OUT
				8-5/8"	224'	

Describe in detail the manner in which the well was plugged, indicating where the mud fluid was placed and the method or methods used in introducing it into the hole. If cement or other plugs were used, state the character of same and depth placed, from _____ feet to _____ feet for each plug set.

Filled hole with mud to 300'.
Set 1st plug at 300' w/20 sx cement & 1/2 sk hulls
Filled hole w/mud to 35'
Set 2nd plug w 1/2 sk hulls & 10 sx cement

RECEIVED
STATE CORPORATION COMMISSION

JUL 8 1959 7-8-59

CONSERVATION DIVISION
Wichita, Kansas

(If additional description is necessary, use BACK of this sheet)
Name of Plugging Contractor Musgrove Petroleum Corporation
Address 801 Union Center, Wichita, Kansas

STATE OF Kansas, COUNTY OF Sedgwick, ss.
Emil E. Bowers (employee of owner) or (owner or operator) of the above-described well, being first duly sworn on oath, says: That I have knowledge of the facts, statements, and matters herein contained and the log of the above-described well as filed and that the same are true and correct. So help me God.

(Signature) Emil E. Bowers
801 Union Center, Wichita, Kansas.
(Address)

SUBSCRIBED AND SWORN to before me this 6th day of July, 19 59

Leah Faye Heike
Leah Faye Heike
Notary Public.

My commission expires June 16, 1963

PLUGGING
FILE SEC. 21, T. 20, R. 13W
BOOK PAGE 42, LINE 33

CONTRACTOR'S WELL LOG

COMPANY: Musgrove Petroleum Corporation
 CONTRACTOR: Musgrove Petroleum Corporation
 FARM: ADAMS #2
 LOCATION: NW SE NE Section 21-20-13W
 Barton County, Kansas
 COMMENCED: June 22, 1959
 COMPLETED: July 2, 1959

o	140	Sand
140	150	Sand & shale
150	175	Hard sand
175	224	Shale
224	750	Red bed
750	780	Anhydrite lime
780	1555	Shale & shells
1555	1710	Shale & lime
1710	1860	Lime
1860	3055	Lime & shale
3055	3502	Lime
3502	3560	Lime & shale
	3560	Rotary Total Depth

RECEIVED
 STATE CORPORATION COMMISSION
 JUL 8 1959
 CONSERVATION DIVISION

Set 8-5/8" surface casing at 224' w/225 sacks Sunset Cement.

DRY & ABANDONED

ELEVATION:	1878' D. F.	TOPS:	Heebner	3133'	(-1252)
	1881' K. B.		Br. Lime	3251'	(-1370)
			Lansing	3266'	(-1385)
			Arbuckle	3530'	(-1649)

STATE OF KANSAS)
) SS
 COUNTY OF SEDGWICK)

I, Emil E. Bowers, do hereby certify that the above and foregoing is a true and correct copy of the log of the ADAMS #2, NW SE NE, Section 21-20-13W, Barton County, Kansas, as reflected by the files of the Musgrove Petroleum Corporation.

Emil E. Bowers
 Emil E. Bowers, Vice President

Subscribed and sworn to before me, a Notary Public, in and for Sedgwick County, Kansas.

Leah Faye Hefke
 Leah Faye Hefke, Notary Public

My commission expires June 16, 1963

PLUGGING
 FILE SEC. 21 T. 20 R. 13W
 BOOK PAGE 48 LINE 33