

STATE OF KANSAS
STATE CORPORATION COMMISSION


Give All Information Completely
Make Required Affidavit
Mail or Deliver Report to:
Conservation Division
State Corporation Commission,
800 Bittling Building
Wichita, Kansas

WELL PLUGGING RECORD

OR

15.009.15917.0000 FORMATION PLUGGING RECORD

Strike out upper line
when reporting plug-
ging off formations.

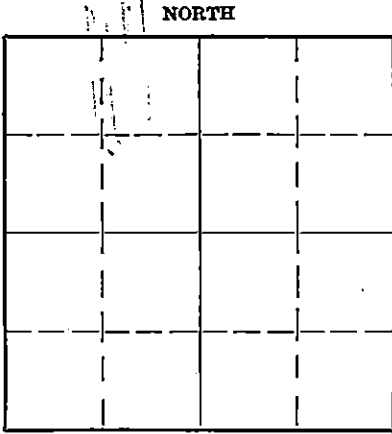

Locate well correctly on above
Section Plat

Barton County. Sec. 21 Twp. 20S Rge. 13W (E) (W)
Location as "NE1/4NW1/4SW1/4" or footage from lines. SEC SW
Lease Owner. Max Cohen
Lease Name. Luse Well No. 1
Office Address. Wichita, Kansas
Character of Well (Completed as Oil, Gas or Dry Hole) Dry Hole
Date, well completed. 9-8-37 193
Application for plugging filed. 9-3-37 193
Application for plugging approved. 9-4-37 193
Plugging Commenced. 9-13-37 193
Plugging Completed. 9-14-37 193
Reason for abandonment of well or producing formation. Dry hole
If a producing well is abandoned, date of last production. 193
Was permission obtained from the Conservation Division or its agents before plugging was commenced?
Yes

Name of Conservation Agent who supervised plugging of this well. C. T. Alexander
Producing formation. Depth to top. Bottom. Total Depth of Well. 3578 Feet
Show depth and thickness of all water, oil and gas formations.


OIL, GAS OR WATER RECORDS

CASING RECORD

Formation	Content	From	To	Size	Put In	Pulled Out

Describe in detail the manner in which the well was plugged, indicating where the mud fluid was placed and the method or methods used in introducing it into the hole. If cement or other plugs were used, state the character of same and depth placed, from _____ feet to _____ feet for each plug set.
Set one bridge hole back to 250' and filled with mud at 195'
Bridge at 195' Put 15 sacks cement and rock. Filled hole up with mud to within 20' of top. Bridge with plug and rock and filled with cement to top of ground.

PLUGGING
FILE SEC 21 T 20 S R 13 W
BOOK PAGE 106 LINE 33

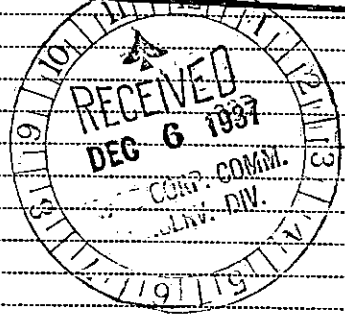

12-6-37

(If additional description is necessary use BACK of this sheet)
Correspondence regarding this well should be addressed to. Torrey and Feaster
Address. 608 Wolcott Building, Hutchinson, Kansas

STATE OF Kansas, COUNTY OF Ren, ss.
O. E. Torrey (employee of owner) or (owner or operator) of the above-described well,
being first duly sworn on oath, says: That I have knowledge of the facts, statements, and matters herein contained and the log of the above-described well as filed and that the same are true and correct. So help me God.

(Signature) Torrey & Feaster
O E Torrey
(Address)

SUBSCRIBED AND SWORN to before me this 4th day of December, 1937

My commission expires Nov. 4, 1939
Ruth Buchenbrode
Notary Public.

W E L L L O G

Luse #1

Sec. 21 T. 20S R. 13W
Sec SW

Total Depth 3578
Commenced 4-14-37
Completed 9-8-37
Contractor Torrey and Feaster

County Barton
Elevation 1884
Production Dry

Casing Record
12" 100'
7" 3288'
5" 3414'

hard sand	138
lime & sand	170
hard lime	179
sand & lime hard	191
shale	209
red rock & shells	590
red bed & shells	835
blue shale & shells	980
shale & shells	1120
lime, shale & shells	1257
shale & salt	1403
shale & shells	1565
lime shells	1649
broken lime	1810
hard lime	1825
broken lime	1914
shale & shells	1995
lime	2057
lime & shale	2120
broken lime	2265
broken lime & shale	2440
lime & shale	2830
sand & shale	2860
lime	3164
black shale	3166
shale	3186
lime	3215
shale	3234
sand	3240
red & grey shale	3270
SIM 3270-	3239
brown lime	3241
shale	3262
lime	3271
slight show oil	3267-8
cored	3271-82 Recovery 9 1/2'
lime	3282
lime	3311
show oil	3291-95
show oil	3302-09
shale	3316
lime	3321
lime show oil	3327
lime	3350
lime show oil	3354
2500' water	3355
lime	3415
lime show oil	3427
filled 300' oil acidized	
1000 gal	
no help --filled 1000' water	
lime	3457
lime slight show oil	3463
lime	3476
brown & grey shale &	
brown & grey lime	3511
conglomerate	3560
siliceous -dolomite	3578
Increase in water	Total depth



PLUGGING
FILE SEC 21 T 20 S R 13 W
BOOK PAGE 106 LINE 33