

WELL PLUGGING RECORD

Give All Information Completely
Make Required Affidavit
Mail or Deliver Report to:
Conservation Division
State Corporation Commission
800 Bldg Building
Wichita, Kansas

Barton County, Sec. 21 Twp. 20 Rge. 13 ~~EX~~ (W)

Location as "NE/CNW $\frac{1}{4}$ SW $\frac{1}{4}$ " or footage from lines 990 West line 330 from South

Lease Owner Schermerhorn Oil Corporation

Lease Name Sand Rock No. 2 Well No. 2

Office Address First National Bldg., Tulsa, Oklahoma

Character of Well (completed as Oil, Gas or Dry Hole) Dry

Date well completed 2-13 1953

Application for plugging filed 2-13 1953

Application for plugging approved 2-13 1953


Plugging commenced 2-13 1953

Plugging completed 2-28 1953

Reason for abandonment of well or producing formation Dry

If a producing well is abandoned, date of last production 19

Was permission obtained from the Conservation Division or its agents before plugging was commenced? Yes

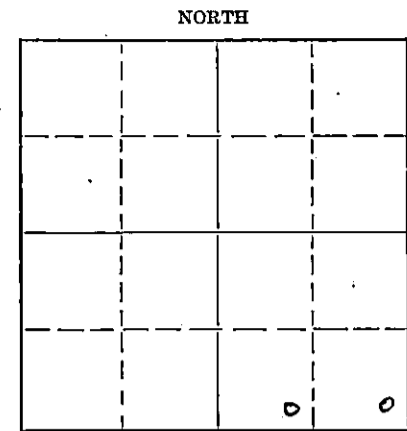

Locate well correctly on above Section Plat

Name of Conservation Agent who supervised plugging of this well J. D. Stough

Producing formation Depth to top Bottom Total Depth of Well 3590 Feet

Show depth and thickness of all water, oil and gas formations.

OIL, GAS OR WATER RECORDS

CASING RECORD

Formation	Content	From	To	Size	Put In	Pulled Out
		0	245	8-5/8		Left in.

Describe in detail the manner in which the well was plugged, indicating where the mud fluid was placed and the method or methods used in introducing it into the hole. If cement or other plugs were used, state the character of same and depth placed, from feet to feet for each plug set.

3590 to 800 Mud
800 to 700 Cement
700 to 420 Mud
420 to bottom cellar cement

3-7-53

STATE CORPORATION COMMISSION

MAR - 7 1953

CONSERVATION DIVISION
Wichita, Kansas

Name of Plugging Contractor Adkins
Address Great Bend, Kansas

STATE OF OKLAHOMA, COUNTY OF TULSA, SS.
Ola Williams (employee of owner) or (owner or operator) of the above-described well,

being first duly sworn on oath, says: That I have knowledge of the facts, statements, and matters herein contained and the log of the above-described well as filed and that the same are true and correct. So help me God.


This is a certified true copy (Signature) (Signed) Ola Williams

Albert, Kansas (Address)

SUBSCRIBED AND SWORN to before me this 6th day of March, 1953.

Notary Public

My commission expires January 7, 1956

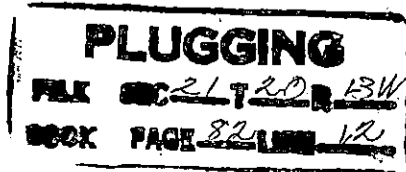

15.009.05698.0000

DRILLERS LOG

Operator- Schermerhorn Oil Corporation
 Lease- Sandrock No. 2 SE SW SE Sec 21-20S-13W. Barton County, Kansas.
 Contractor- Adkins Drilling Company, Inc. Great Bend, Kansas.

Formation	From	To	Formation	From	To
Surface Soil	0	35'	Lime	2960	3590
Sand	35	110			
Sand, Rick & Shale	110	245	T. D. of Hole	3590'	
Set 8 5/8" surface pipe @ 240'			Dry & Abandoned @ 3590'		
cemented with 300 sacks cement					
Cement	222	240			
Open Hole	240	245			
Shale & Red Bed	245	1365			
Shale & Shells	1365	1690			
Lime & Shale	1690	2080			
Shale & Lime	2080	2300			
Lime & Shale	2300	2475			
Shale	2475	2585			
Shale & Lime	2585	2960			

I hereby Certify that the foregoing is a true and correct copy of
 Drillers Log of Sandrock No. 2 drilled the SE SW SE Sec. 21-20S-13 W. Barton
 County, Kansas.

Adkins Drilling Company, Inc.

By (Signed) Jim Adkins
 President.

This is a certified true copy.

State of Oklahoma, County of Tulsa, this 6th day of March, 1953.

RECEIVED
 STATE CORPORATION COMMISSION

Eva M. Davis

Notary Public

CONSERVATION DIVISION

My commission expires: January 7, 1956.